

SURVEY & REMONUMENTATION

117195

MAY 05 1997

REMONUMENTATION CORNER

LAND CORNER RECORDATION CERTIFICATE

COMMISSION

Filing Requirement of Act 74, Mich. P.A. 1970

STATE OF MICHIGAN
COUNTY OF ISABELLA
RECEIVED FOR RECORD

JAN 23 1 11 PM '97
000155
SHARON A. BROWN
REGISTER OF DEEDS

For corners in
Isabella
(County)

Located In:

Corner Code #

1. Public Land Survey

T 14N R 6W

A-9

T R
T R
T R
T R
S T R
S T R
S T R
S T R

2. Property Controlling
in Section

3. Miscellaneous
Property in Sec.

4. Lot No. _____, Recorded Plat _____

5. Private Claims _____

Register of Deeds Stamp & File Number

I, Ronald R. Harris, in a field survey on October 18, 1996, do hereby certify that under requirements of P.A. 74, Michigan P.A. of 1970, the corner points mentioned in lines 1 and 2 above were in conformance with regulations and rules therefore as required in the current manual of survey instructions of the United States Department of the Interior, Bureau of Land Management or by a decree of a Court of Law and/or that the corner points mentioned in lines 3, 4 and 5 above were in conformance with the rules of the Michigan Board of Land Surveyors or by a Decree of a Court of Law; established, re-established, monumented, re-monumented, recovered, found as expressed below:


NOTE: Not more than 4 corners, all in the same town and range, may be recorded on this certificate.

A. Description of original monument and accessories and/or subsequent restoration:

April 1837 Post by John Hodson in Survey of Sec 25, T14N-R7W
1904 Stone set by Mecosta County. Held by Denslow as recorded in County Surveyor Record Bk 4, P 20
1974 LCRC by W.B. Ruddell. Recorded P181. Fd spike in centerline of pavement. Survey by Ruddell L 1, P 68 (1972)
1838 Original survey by Noah Brookfield shows common corners with Mecosta County
No other record of this corner in Mecosta County, but corners to North (W 1/4 and NW corner of Section 19) show common corners with Isabella County per Mecosta County L.C.R.C. Liber 1, Page 42 by Matt Koivisto, 1967, (E 1/4 and NE corner of Section 24, T14N-R7W)

B. Description of corner evidence found and/or method applied in restoring or reestablishing corner:

Oct 1996 Under cold patch, found cap iron top missing
Fits witnesses from 1972
Witnessed and removed. Dug to depth of 4'. Still in road fill. Found no other evidence.
Reset corner

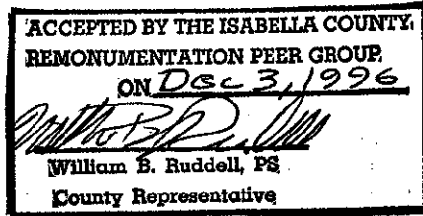

C. Description of monument for corner and accessories established to perpetuate locating the position of the corner:

A standard remonumentation corner was set/stamped with corners code number (A-9) and P.S. 41917 in monument box and is accepted as the best available evidence of the position of the original corner.

WITNESSES:

NW 45.17' Nail & tag in cut off telephone pole
NE 51.26' Nail & tag in power pole
SE 44.48' Nail & tag in West leg of Hall's Lake sign
SW 47.24' Chiseled mark in top of centerline of West end of 15" CMP
NW 41.80' Centerline of old sign post (1972)

Signed by R. R. Harris

Date 1/22/97

Surveyor's Michigan License No. 41917

