


10730

ISABELLA  
REMONUMENTATION

JAN 19 2001

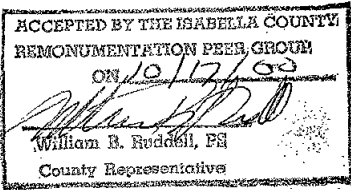

Isabella County Remonumentation Program  
LAND CORNER RECORDATION CERTIFICATE  
Filing Requirement of Act 74, Mich. P.A. 1970

SECTION

Instrument Liber Page  
200000010730 1 349

For corners in

ISABELLA Located in: Corner Code  
(County) Sherman Twp.

200000010730  
Filed for Record in  
ISABELLA COUNTY, MI  
SHARON A BROWN  
On 12-08-2000 At 02:33:06 pm.  
RE LAND COR 9.00  
Liber 1 Page 349 - 349

Register of Deeds Stamp & File Number

- 1. Public Land Survey T 15N R6W A-2 ✓  
T 15N RTW M-2 Mecosta
- 2. Property Controlling S T R  
in Section S T R
- 3. Miscellaneous S T R  
Property in Sec. S T R
- 4. Lot No. \_\_\_\_\_, Recorded Plat \_\_\_\_\_
- 5. Private Claims \_\_\_\_\_

	A	B	C	D	E	F	G	H	I	J	K	L	M
2	6	5	4	3	2	1							
3													
4	7	8	9	10	11	12							
5													
6	18	17	16	15	14	13							
7													
8	19	20	21	22	23	24							
9													
10	30	29	28	27	26	25							
11													
12	31	32	33	34	35	36							
13													

I, John H. Rauser, P.S., in a field survey on October 24, 2000 do hereby certify that under requirements of P.A. 74, Michigan P.A. of 1970, the corner points mentioned in lines 1 and 2 above were in conformance with regulations and rules therefore as required in the current manual of survey instructions of the United States Department of the Interior, Bureau of Land Management or by a decree of a Court of Law and/or that the corner points mentioned in lines 3, 4 and 5 above were in conformance with the rules of the Michigan Board of Land Surveyors or by a Decree of a Court of Law; established, re-established, monumented, re-monumented, recovered, found as expressed below:

NOTE: Not more than 4 corners, all in the same town and range, may be recorded on this certificate.

A. Description of original monument and accessories and/or subsequent restoration:

A-2 West 1/4 Corner, Section 6, T15N-R6W, Sherman Township, Isabella County  
Corner common with M-2, T15N-R7W, Mecosta County

- 1837 Corner established by John Hodgson, D.S., Witnessed by Beech 8" N67W, 7 lks (4.62 feet); Beech 8" S72W, 10 lks (6.60 feet) corner is common by instruction with M-2, T15N-R7W
- 1895-6 Lyman W. June, County Surveyor, Mecosta County, appointed by the township board to perpetuate the government survey corners in T15N-R7W, as recorded in county surveyors Book No. 1 Pages 288 - 289 (Field Bok No. 1, Pages 67-75) Corner as noted: "Tile S. side of sluice - stake, 50 lks west one O.B.T. stump - shown by A.H. Strong
- 1900 County survey by Lyman June, Mecosta County Records, Field Book 3, Page 138, tile corner. 42.54 chains to M-1, T15N-R7W (Twp. Corner common with A-1, T15N-R6W) and 40.04 chains M-3, T15N-R7W (common with A-3, T15N-R6W).
- 1997 L.C.R.C.#1368 & Recorded Survey 132 Liber 005, Pg. 608 by Ronald Harris P.S. #41917, Found 5/8"x24" rod 18" below grade, raised by capped re-rod,
- 2000 Mecosta County Remonumentation Program, found 1/2" X 18" re-bar with cap, "Ruddell Eng. P.S. 41917", buried 3" below gravel road surface, at 24" found 1/2" iron rod, at 30" found vitrified clay tile and rotten wood in center of Costabella Road, and 3' south of remains of fence - East. Notes from the Mecosta preliminary field search for 2000 remon program


B. Description of corner evidence found and/or method applied in restoring or reestablishing corner:

A-2 West 1/4 Corner, Section 6, T15N-R6W, Sherman Township, Isabella County  
Corner is existent. Found rod raised with re-rod as listed in the 1997 records. Found three of the four witnesses. Excavated under re-rod and found 5/8" x 2.3' rod surrounded by 6"-8" stones. Found rotten wood stake 0.15' South and 0.2' West of rod at a depth of 2.5'. Also found 1/2" iron rod 0.2' West and 0.2' North of wood stake. Wood stake was also surrounded by stones. The stones were removed to set remonumentation monument. Left bottom rod in place. We accept the found wood stake as a careful and faithful perpetuation of the position of the original corner.

C. Description of monument for corner and accessories established to perpetuate locating the position of the corner:

A-2 West 1/4 Corner, Section 6, T15N-R6W, Sherman Township, Isabella County  
Set standard Isabella County monument and monument box in centerline of grade stamped A-2, #39096.  
N30E 55.15' N&T in 7" Cherry 08T (1997)  
SE 29.18' N&T in 10" Poplar 08T (1997)  
SW 46.55' N&T in 10" Poplar 08T (1997)  
N25W 54.70' N&T in 10" Ash

Signed by John H. Rauser  
Surveyor's Michigan License No. 39096

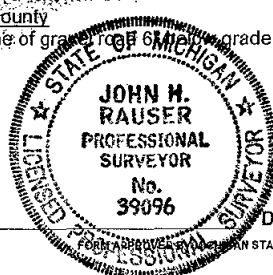

Date 12/7/00