

10731


DOCUMENTATION

JAN 19 2001

SECTION

Isabella County Remonumentation Program
LAND CORNER RECORDATION CERTIFICATE
 Filing Requirement of Act 74, Mich. P.A. 1970

Instrument 200000010731 Liber 1 Page 350

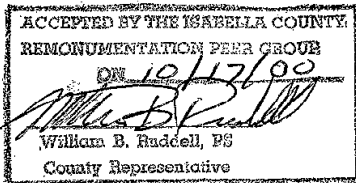

For corners in

ISABELLA Located In: Sherman Twp. Corner Code _____
 (County)

1. Public Land Survey T 15N R6W A-3 ✓ *Mecosta*
 T 15N R 7W M-3
 T R
 T R
2. Property Controlling S T R
 in Section S T R
 3. Miscellaneous S T R
 Property in Sec. S T R

4. Lot No. _____, Recorded Plat _____
 5. Private Claims _____

I, John H. Rauser, P.S., in a field survey on October 24 20 00, do hereby certify that under requirements of P.A. 74, Michigan P.A. of 1970, the corner points mentioned in lines 1 and 2 above were in conformance with regulations and rules therefore as required in the current manual of survey instructions of the United States Department of the Interior, Bureau of Land Management or by a decree of a Court of Law and/or that the corner points mentioned in lines 3, 4 and 5 above were in conformance with the rules of the Michigan Board of Land Surveyors or by a Decree of a Court of Law; established, re-established, monumented, re-monumented, recovered, found as expressed below:

NOTE: Not more than 4 corners, all in the same town and range, may be recorded on this certificate.

	A	B	C	D	E	F	G	H	I	J	K	L	M
1													
2	6	5	4	3	2	1							
3													
4	7	8	9	10	11	12							
5													
6	18	17	16	15	14	13							
7													
8	19	20	21	22	23	24							
9													
10	30	29	28	27	26	25							
11													
12	31	32	33	34	35	36							
13													

A. Description of original monument and accessories and/or subsequent restoration:

A-3 Section Corner common to Sections 6 & 7, T15N-R6W, Sherman Township, Isabella County
 Corner common to M-3, T15N-R7W, Mecosta County

- 1837 GLO wood post placed by John Hodgson, D.S., Listed two accessories: S28W 56lks (36.96') 12" Beech;
 corner is common by instruction with M-3, T15N-R7W N74W 40lks (26.40') 26" Sugar,
- 1847 Deputy Surveyor, Arron Lynn, found corner and re-witnesses it during resurvey of T15N-R6W, listed two accessories:
 N58E 36 lks (23.76') 7" Birch
 S23½E 35 lks (23.10') 9" Hemlock
- 1870 Found 3"x3" stake, A.R. Arnold - County Surveyor
- 1895-8 Lyman W. June, County Surveyor, Mecosta County, appointed by the township board to perpetuate the government survey corners in T15N-R7W, as recorded in county surveyors Book No. 1 Pages 288 - 289 (Field Book No. 1, Pages 67-75) Corner as noted "Larger stone with tile - one O.B.T. stump - Cherry 5 N30E 112.
- 1900 County survey by Lyman June, Mecosta County Records, Field Book 3, Page 138, tile corner. 39.50 chains (2607.00 feet) to L-3 and 40.04 chains (2642.64 feet) to M-2, T15N-R7W.
- 1997 LCRC 1368 & Recorded Survey 132, L.005, Pg. 607 & 608, Ronald Harris PS. #41917, Fnd re-rod and Flagging 18" below grade Raised with Re-rod,


B. Description of corner evidence found and/or method applied in restoring or reestablishing corner:

A-3 Section Corner common to Sections 6 & 7, T15N-R6W, Sherman Township, Isabella County
 Corner is existent. Found no physical evidence of original or county survey. Found ½" re-rod as called for in 1997 record. Excavated and found another ½" rod at a depth of 2'. Found 9 4"-6" stones surrounding rerod. Removed stones and re-rod. Excavated to a total depth of 3.9', finding no other evidence. We accept the found re-rod as the best available evidence of the position of the original government corner.

C. Description of monument for corner and accessories established to perpetuate locating the position of the corner:

A-3 Section Corner common to Sections 6 & 7, T15N-R6W, Sherman Township, Isabella County.
 Set standard Isabella County monument and monument box 6" below grade in centerline intersection stamped A-3, #39096
 SW 45.55' Spike in Northwesterly side Power Pole
 ESE 26.4' Centerline of south gate post
 N60W 58.85' Spike in Southwesterly side 6" deciduous tree
 NNE 64.15' Spike in Westerly side 8" deciduous tree

Signed by John H. Rauser
 Surveyor's Michigan License No. 39096

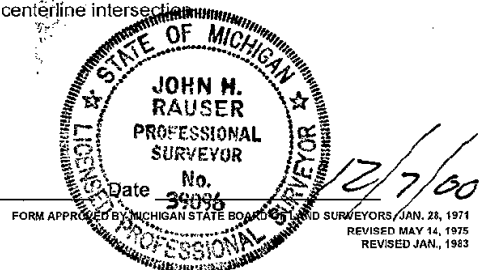

FORM APPROVED BY MICHIGAN STATE BOARD OF LAND SURVEYORS, JAN. 28, 1971
 REVISED MAY 14, 1975
 REVISED JAN., 1983