


10733

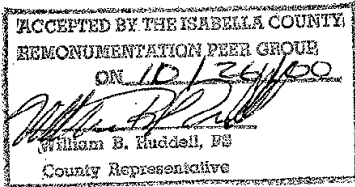

JAN 19 2001

SECTION

Isabella County Remonumentation Program
LAND CORNER RECORDATION CERTIFICATE
Filing Requirement of Act 74, Mich. P.A. 1970

Instrument Libe
200000010733

For corners in

ISABELLA Located In: Corner Code
(County) Sherman Twp.

1. Public Land Survey T 15N R6W B-3
T R
T R
T R
T R
2. Property Controlling S T R
in Section S T R
3. Miscellaneous S T R
Property in Sec. S T R
4. Lot No. _____, Recorded Plat _____
5. Private Claims _____

Instrument Libe Page
200000010733 1 352
200000010733
Filed for Record in
ISABELLA COUNTY, MI
SHARON A BROWN
On 12-08-2000 At 02:33:15 pm.
RE LAND COR 9.00
Liber 1 Page 352 - 352

Register of Deeds Stamp & File Number

I, John H. Rauser, P.S., in a field survey on November 1 20 00
do hereby certify that under requirements of P.A. 74, Michigan P.A. of 1970, the corner points mentioned
in lines 1 and 2 above were in conformance with regulations and rules therefore as required in the 6
current manual of survey instructions of the United States Department of the Interior, Bureau of Land
Management or by a decree of a Court of Law and/or that the corner points mentioned in lines 3, 4 and 5
above were in conformance with the rules of the Michigan Board of Land Surveyors or by a Decree of a
Court of Law; established, re-established, monumented, re-monumented, recovered, found as
expressed below:

NOTE: Not more than 4 corners, all in the same town and range, may be recorded
on this certificate.

	A	B	C	D	E	F	G	H	I	J	K	L	M
1													
2	6	5	4	3	2	1							
3													
4	7	8	9	10	11	12							
5													
6	18	17	16	15	14	13							
7													
8	19	20	21	22	23	24							
9													
10	30	29	28	27	26	25							
11													
12	31	32	33	34	35	36							
13													

A. Description of original monument and accessories and/or subsequent restoration:

- B-3 1/4 Corner common to Sections 6 & 7, T15N-R6W, Sherman Township, Isabella County
1847 GLO wood post placed by Arron Lynn, D.S., during a resurvey of T16N-R6W, measured 37.14 ch (2451.24') to A-3 & 40.00 ch to
C-3, listed two accessories:
N81½W 35 lks (23.10') 24" Birch
S15W 33 lks (21.78') 6" Elm
1870 County survey, Book 1, Page 45, no object or witnesses listed
1997 Recorded Survey 132, Liber 005 Pg. 607, by Ronald Harris P.S. No. 41917, shows calculated position for corner.

B. Description of corner evidence found and/or method applied in restoring or reestablishing corner:

B-3 1/4 Corner common to Sections 6 & 7, T15N-R6W, Sherman Township, Isabella County

Corner is obliterated. Found no evidence of original corner or accessories. Calculated a corner position based on 1997 record. We
used the calculated east-west position, from the 1997 record survey, as proportioned from the 1870 county survey and a north-south
position being placed in the occupied fence line running east and west. Found traces of old fencing southerly at this position.
Traced the fence line westerly approximately 1/4 mile. Using the calculated position and the found A-3 position the fence line
westerly from B-3 is within 2' of a straight line. The fence in this area is circled with stones which have been placed around a wood
fence post. Measured east to the Chippewa River 527' to the westerly bank (river approximately 30-35 feet wide), GLO measure
from westerly bank of river is 475 feet. We accept the calculated position as a careful and faithful re-establishment of the position of
the original government corner.

C. Description of monument for corner and accessories established to perpetuate locating the position of the corner:

- B-3 1/4 Corner common to Sections 6 & 7, T15N-R6W, Sherman Township, Isabella County
Set standard Isabella County monument 0.3' above grade in east-west fence line in stone pile.
Stamped B-3, #39096
NNW 31.24' Spike w/flag in SW face 26" maple
NE 13.09' Spike w/flag in NW face 10" ash
SW 5.59' Spike w/flag in SE face of clump of 6" maple
East 47.65' Spike w/flag in N face of 8" birch

Signed by
Surveyor's Michigan License No. 39096



FORM APPROVED BY MICHIGAN BOARD OF LAND SURVEYORS, JAN. 28, 1971
REVISED MAY 14, 1975
REVISED JAN., 1983
ADAPTED FOR WORD PROCESSING MARCH, 1986