

SURVEY &  
REMONUMENTATION  
APR 29 1995  
COMMISSION

REMONUMENTATION CORNER

LAND CORNER RECORDATION CERTIFICATE

Filing Requirement of Act 74, Mich. P.A. 1970

For corners in ISABELLA  
(County)

Located In:

Corner Code #

1. Public Land Survey T 16N R 5W D-11  
T      R       
T      R       
T      R       
2. Property Controlling S      T      R       
in Section S      T      R       
3. Miscellaneous S      T      R       
Property in Section S      T      R

4. Lot No.                     , Recorded Plat                       
5. Private Claims

STATE OF MICHIGAN  
COUNTY OF ISABELLA  
RECEIVED FOR RECORD

Dec 11 10 38 AM '95  
000078  
SHARON A. BROWN  
REGISTER OF DEEDS

Register of Deeds Stamp & File Number

I, PAUL B. LAPHAM, in a field survey on OCTOBER, 19 95

do hereby certify that under requirements of P.A. 74, Michigan P.A. of 1970, the corner points mentioned in lines 1 and 2 above were in conformance with regulations and rules therefore as required in the current manual of survey instructions of the United States Department of the Interior, Bureau of Land Management or by a decree of a Court of Law and/or that the corner points mentioned in lines 3, 4 and 5 above were in conformance with the rules of the Michigan Board of Professional Surveyors or by a Decree of a Court of Law; established, re-established, monumented, re-monumented, recovered, found as expressed below:

NOTE: Not more than 4 corners, all in the same town and range, may be recorded on this certificate.

A. Description of original monument and accessories and/or subsequent restoration:

1837 NICHOLSON, G.L.O.

1850 BURT, G.L.O. RESURVEY

SET POST

WIT.-(1)MAPLE 8" N89°W 17 LKS.

(2)PINE 18" S45°W 27 LKS.

1910 TRUSSELL, C.S.R. 4-107

FOUND GAS PIPE, SET 5"x5"x4' CEDAR POST

WELL STONED AROUND.

WIT.-(3)NORWAY PINE 8" N68 1/2°E, 72 1/4

(4)NORWAY PINE 8" S65 1/2°W, 130 1/2

1-2-76 LAPHAM, L.C.R.C. 354

FOUND 1 1/4" PIPE

WIT.-(5)N50°W 41.30' 8" JACK PINE

(6)S50°E 43.70' 6" PINE

(7)SOUTH 30.00' 3" PIPE

2-20-76 FLUHARTY, L.C.R.C. 357

FOUND 1 1/4" PIPE CENTER S. SIDE 6"

TOP DIA. STONE OFF FENCES N & S.

WIT.-(8)P.P. N05°W, 46.17'

(5) & (6) ABOVE

10-12-76 LAPHAM, (132) 2-412 & 413

FOUND 1 1/4" PIPE

WIT.-(5), (6) & (7) ABOVE

4-10-78 LAPHAM, (132) 3-630-634  
FOUND 1 1/4" PIPE  
WIT.-(5), (6) & (7) ABOVE


8-23-78 LAPHAM, (132) 3-200  
FOUND 1 1/4" PIPE  
WIT.-(5), (6) & (7) ABOVE

1-28-85 FLUHARTY, (132) 4-173  
FOUND 1 1/4" PIPE  
WIT.-(5), (6) & (8) ABOVE

2-1-85 FLUHARTY, L.C.R.C. 744  
SAME AS L.C.R.C. 357

B. Description of corner evidence found and/or method applied in restoring or reestablishing corner:

FOUND 1 1/4"x30" PIPE (WELL POINT). FOUND 1-2-76 WITNESSES AND 2-20-76 WITNESSES.

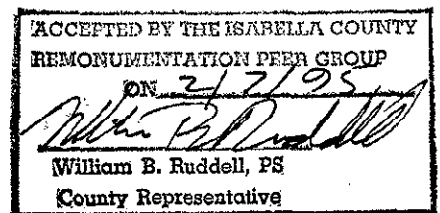

This Corner established in Isabella County Remonumentation Program.

See dossier for detailed report.

C. Description of monument for corner and accessories established to perpetuate locating the position of the corner:

D-11: 1/4 CORNER COMMON TO SECTIONS 29 & 32

SET 1/2"x24" STANDARD MONUMENT WITH CAP MARKED D-11, P.S. NO. 9433.

ACCEPTED AS BEST AVAILABLE EVIDENCE OF THE ACCEPTED POSITION OF THE CORNER.

WITNESSES:

N50°W 41.30' - NAIL & TAG IN 12" JACK PINE (OBT)

SOUTH 30.00' - 3" PIPE (OBT)

N05°W 46.17' - NAIL & TAG IN P. POLE (OBT)

S45°E 38.72' - NAIL & TAG IN 7" RED PINE



Signed by Paul B. Lapham

Date 12-01-95

Surveyor's Michigan License No. 9433