

LAND CORNER RECORDATION CERTIFICATE
Filing Requirement of Act 74, Mich. P.A. 1970
Isabella County Remonumentation

JAN 23 2000

For Corners in
Isabella

SECTION

(County) Located In: Corner Code#:

1. Public Land Survey T. 16N R. 5W E-2
T. R.
T. R.
2. Public Controlling S. T. R.
in Section S. T. R.
3. Miscellaneous S. T. R.
Property in Section S. T. R.
4. Lot No. , Recorded Plat
5. Private Claims

199900012541
Filed for Record in
ISABELLA COUNTY, MI
SHARON A BROWN
On 12-16-1999 At 08:33:18 am.
RE LAND COR 9.00
Liber 1 Page 320 - 320

Register of Deeds Stamp & File Number


I, Jan S. Fokens, in a field survey on November 23, 1999, do hereby certify that under requirements of P.A. 74, Michigan P.A. of 1970, the corner points mentioned in lines 1 and 2 above were in conformance with regulations and rules therefore as required in the current manual of survey instructions of the United States Department of the Interior, Bureau of Land Management or by a decree of a Court of Law and/or that the corner points mentioned in lines 3, 4 and 5 above were in conformance with the rules of the Michigan Board of Land Surveyors or by a Decree of a Court of Law, established, re-established, monumented, re-monumented, recovered, found as expressed below.

NOTE: Not more than 2 corners, all in the same town and range, may be recorded on this certificate.

A. Description of original monument and accessories and/or subsequent restoration:

1. G.L.O Original Survey
Township: John Hodgson May, 1837
Subdivision: Henry Nicholson October, 1837
Pages 508, 550, 570 original field notes
2. County Survey Records:
None of Record
3. L.C.R.C.:
Liber 4, Page 1136 Herbert Fluharty January 21, 1992 Found 3/4" pipe on N/S fence and on fence to W.
4. Surveys of Record:
None of Record
5. Unrecorded Survey:
None Available

	A	B	C	D	E	F	G	H	I	J	K	L	M
1													
2	6	5	4	3	2	1							
3													
4	7	8	9	10	11	12							
5													
6	18	17	16	15	14	13							
7													
8	19	20	21	22	23	24							
9													
10	30	29	28	27	26	25							
11													
12	31	32	33	34	35	36							
13													

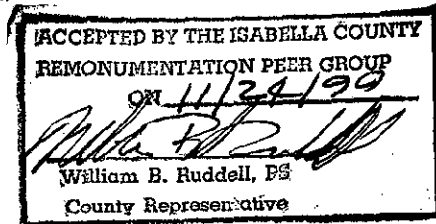

B. Description of corner evidence found and/or method applied in restoring or re-establishing corner:

This corner established in Isabella County Remonumentation Program. See dossier for detailed report.

This is an existent corner.

1. Found 3/4" pipe surrounded by fences posts belonging to fences running N/S and W.
2. Excavated to 2.5'. Found no further evidence

Accepted as the best available evidence of the position of the accepted corner and replaced with Standard Monument Corner.


C. Description of monument for corner and accessories established to perpetuate locating the position of the corner:

Set Standard Isabella County Monument in Monument Box, stamped E-2 and PS 21567.

E-2 E. 1/4 Corner, Section 5, T.16N.-R.5W., Gilmore Twp., Isabella Co, MI

S.25°W. 15.84' Set LSC nail and cap in W. face of 10" Maple tree
N.65°W. 17.02' Set LSC nail and cap in N. face of 30" Oak tree
S.38°E. 33.88' Set LSC nail and cap in SW. face of 6" Maple tree
S.88°E. 8.82' Set LSC nail and cap in N. face of 14" Maple tree
N.00°37'19"W. 2736.02' (E-1) NE. Corner, Section 5, T.16N.-R.3W., Gilmore Twp., Isabella Co., MI.
S.00°53'19"W. 2631.94' (E-3) SE. Corner, Section 5, T.16N.-R.3W., Gilmore Twp., Isabella Co., MI.

Signed by Jan S. Fokens
Surveyor's Michigan License No. 21567

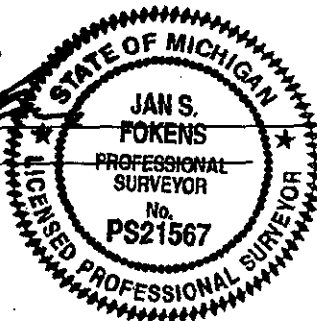

Date 12/14/99

FORM APPROVED BY MICHIGAN STATE BOARD OF LAND SURVEYORS, JAN.28, 1971
REVISED MAY 14, 1975
REVISED JAN., 1983