


JAN 19 2001

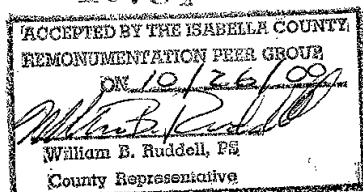

Isabella County Remonumentation Program
LAND CORNER RECORDATION CERTIFICATE
Filing Requirement of Act 74, Mich. P.A. 1970

For corners in

ISABELLA
(County)

Located In:
Sherman Twp.

Corner Code

1. Public Land Survey

T 15N R6W C-1
T 16N R6W C-13 ✓

2. Property Controlling in Section

S_____ T_____ R_____

S_____ T_____ R_____

3. Miscellaneous Property in Se

S _____ T _____ R _____
S _____ T _____ R _____

4. Lot No. _____, Recorded Plat _____

5. Private Claims

I, John H. Rauser, P.S., in a field survey on November 1, 2000, do hereby certify that under requirements of P.A. 74, Michigan P.A. of 1970, the corner points mentioned in lines 1 and 2 above were in conformance with regulations and rules therefore as required in the current manual of survey instructions of the United States Department of the Interior, Bureau of Land Management or by a decree of a Court of Law and/or that the corner points mentioned in lines 3, 4 and 5 above were in conformance with the rules of the Michigan Board of Land Surveyors or by a Decree of a Court of Law; established, re-established, monumented, re-monumented, recovered, found as expressed below:

NOTE: Not more than 4 corners, all in the same town and range, may be recorded on this certificate.

A. Description of original monument and accessories and/or subsequent restoration:

C-1 Section Corner common to Sections 5 & 6, T15N-R6W, Sherman Township, Isabella County
Corner is common with C-13, T16N-R6W, by original notes of resurvey.

1847 GLO wood post found by Arron Lynn, D.S., during resurvey of T15N-R6W, 4th old corner 27 lks (17.82') West of 5 & 6, held and corrected back. Listed two accessories:

S43½W 13 lks (8.58') 7" Beech

S63½E 3 ½ lks (2.31') 7" Beech

1974 Certified Survey Act 132, L.001 Pg. 574-575, Set ½" iron rod

1974 Act 74 form by Gerald Gray #17741, L.C.R.C. #00325, Set 1/2" Iron Rod to evidence

1981 Certified Survey Act 132, L.003, Pg. 606, Thomas J. Mueller P.S.#25861. Measured 2729.86' to C-2.

1988 Act 74 form by William Ruddell #14769, L.C.R.C. #918, Found Solid rod beside stone in line with fence South, S 4.0' Found Re-rod, W 94.42' Found Re-rod

1997 Act 74 by Ron Harris #41917, LCRC #1370, found solid shaft, S 4.00' solid rod, W 94.40' fnd. re-rod

1997 Witness record from road commission calls for 3/4" iron on N side of large stone, witnessed by N45E 45.95' Nail in utility pole by phone ped, South 61.85' Nail & fence insulator on E-side of 10" post, N60W 47.41' survey tag in south face of fence post.

1997 Witness record from road commission calls for found iron rod on N side of large stone (also 3/4 x 3/4 x 9" pointed iron under stone and other iron), witnessed by South 62.00' Nail in electric fence insulator in 9" cedar post in fence row, S30E 63.91' 2x2 tacked hub, N30W 73.29' 2x2 tacked hub. Set 1/2" rebar using these witnesses.

B. Description of corner evidence found and/or method applied in restoring or reestablishing corner:

C-1 Section Corner common to Sections 5 & 6, T15N-R6W, Sherman Township, Isabella County

Corner is existent. Found no evidence of original survey or accessories. Found 5/8"x 12" re-rod (top 4" bent) 15" below grade. Found re-rod appears to have been set by the road commission. Excavated this position as well as 4' South. Found no conflicting evidence. We accept the found re-rod be as the best available evidence of the position of the original government corner.

C. Description of monument for corner and accessories established to perpetuate locating the position of the corner:

C-1 Section Corner common to Sections 5 & 6, T15N-R6W, Sherman Township, Isabella County


Set standard Isabella County monument in monument box in centerline of Vernon Road and 4' west of centerline of Sherman Road north, 6" below grade, stamped C-1, #39096.

S55W 38.26' Set traverse point cap on re-rod

South	23.45'	Top centerline East end of CMP
-------	--------	--------------------------------

N20W	52.24'	East edge yield sign post
------	--------	---------------------------

N60W 76.1' South edge sign post

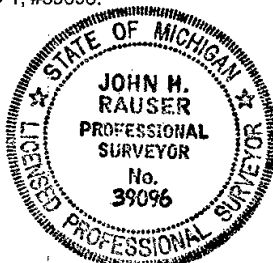

Signed by [Signature]
Surveyor's Michigan License No. 39096

Date 12/7/00