

STATE OF MICHIGAN
DEPARTMENT
OF
NATURAL RESOURCES
LAND CORNER RECORD


Jackson COUNTY
T 1.5. R 2.E.

DESCRIPTION OF CORNER South $\frac{1}{4}$ Corner of Sec. 10 T15.R.2.E.

CORNER MONUMENT $\frac{3}{4}$ x 30" Iron Pipe

DATE MONUMENT PLACED AND WITNESSED Set & Witnessed 3-20-69

WITNESSES TO CORNER..... S. 30° W. 4.3' 36" Oak PK nail tag
in E. side of tape

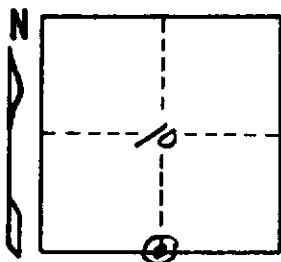


CIRCLE CORNER REGISTERED

S. 62° E. 7.15' 4" Elm PK nail tag S.W.
side of tape

East 1.5' Steel Fence Post in fence
Fence line

AND
Pipe is at E.W.N.S. fence intersection

DESCRIPTION IN DETAIL AS TO HOW CORNER WAS LOCATED AND IDENTIFIED OR RESTORED.

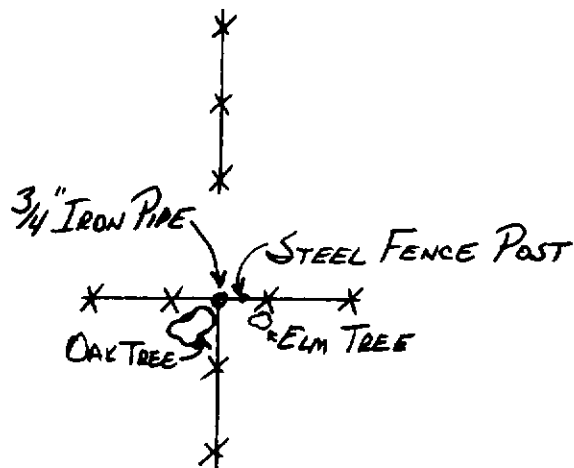

SURVEYOR'S SEAL

SIGNED

[Signature]
REGISTERED LAND SURVEYOR

DATE

4/1/69

DISTRIBUTION:

County Courthouse
Area Forester (Regions I & II)
District or Region Surveyor
Forestry Div., Lansing