


T. 2 S R. 2 E

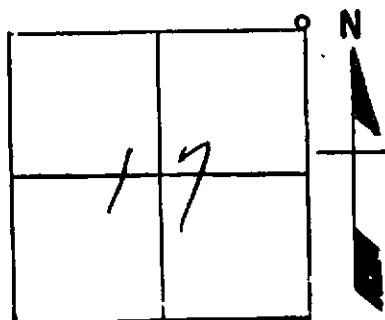

WITNESSES

14" Oak - S 76° W - 11.96'
12" Oak - S 20° E - 8.33'
12" Oak - S 77° E - 13.47'

Jackson Co. SEC. 17

REMARKS

Found 1½" Gas Pipe in place.

DELMATER-MUSCHELL

Engineering and Land Surveying
Cheboygan, Michigan