

Chairman Dean C. [Signature]
 Date 11-24-99

SURVEY & REMONUMENTATION

MAR 13 2000

LAND CORNER RECORDATION CERTIFICATE
 Filing Requirement of Act 74, Mich. P.A. 1970

For corners in Jackson Located In: _____ Corner Code # _____
 (County)

1. Public Land Survey T 3 S R 1 W E-9
 T _____ R _____
 T _____ R _____
 T _____ R _____

2. Property Controlling S _____ T _____ R _____
 in Section S _____ T _____ R _____

3. Miscellaneous S _____ T _____ R _____
 Property in Section S _____ T _____ R _____




SECTION
2139378
 Page: 1 of 2
 12/08/1999 11:41A
 L-1618 P-1232

Register of Deeds Stamp & File Number

4. Lot No. _____, Recorded Plat _____
 5. Private Claims _____

Timothy B. VanGieson, in a field survey on May 07, 1998, do hereby certify that under requirements of P.A. 74, Michigan P.A. of 1970, the corner points mentioned in lines 1 and 2 above were in conformance with regulations and rules therefore as required by the current manual of survey instructions of the United States Department of the Interior, Bureau of Land Management or by a decree of a Court of Law and/or that the corner points mentioned in lines 3, 4 and 5 above were in conformance with the rules of the Michigan Board of Professional Surveyors or by a Decree of a Court of Law; established, re-established, monumented, re-monumented, recovered, found as expressed below:

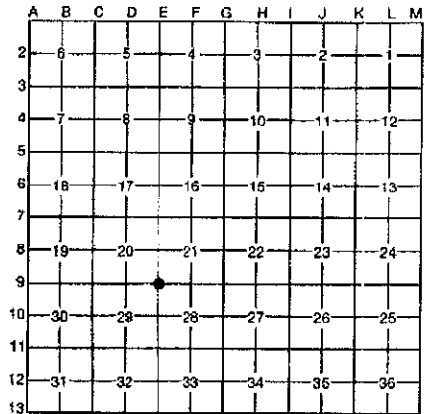

NOTE: Not more than 4 corners, all in the same town and range, may be recorded on this certificate.

- A. Description of original monument and accessories and/or subsequent restoration:**
- E-9: Original government survey dated February 26, 1825 "80.00 ch. (5,280.00') set post corner 20, 21, 28, 29." "Wood Post" Elm 30" S 21° E 44 lks. (29.04') Lynn 20" N 18° W 34 lks. (22.40') Hervey Parke (Deputy Surveyor) May 04, 1825
 - E-9: Remonumentation survey dated 1886 "Post standing witness are good ones." "Fire Clay" White Ash 14" S 67° W 22-1/4 lks. (14.685') H.F. Bean 1886
 - E-9: See back for additional supporting documentation

- B. Description of corner evidence found and/or method applied in restoring or reestablishing corner:**
- E-9: Found fire clay standing 1.1' above ground level with 3/4" pipe on North side. Hand dug below fire clay, in search of memorials, to a depth of 2'± below existing ground surface (static water table) but found none. Accepted fire clay as faithful and careful perpetuation of E-9.
- Set standard Jackson County Remonumentation "Berntsen" monument. Left fire clay and 3/4" pipe on South side of monument flush with existing ground level.

- C. Description of monument for corner and accessories established to perpetuate locating the position of the corner:**
- E-9: 36" Berntsen monument with aluminum cap R.L.S. No. 24621
 - N 00° E Sign post 0.5'±
 - N 65° E 60-d in Southeast side 22" Ash 76.36'
 - N 85° E 60-d in North side 9" Maple 12.88'
 - S 55° W 60-d in Southeast side 20" Maple 75.69'
 - S 68° W 60-d in South side 10" Basswood 33.08'
 - N 75° W 60-d in North side 18" Maple 18.88'
 - N 12° W 60-d in West side 13" Ash 66.87'



Signed by Timothy B. VanGieson Date November 23, 1999

A (continued)

Source: P.A. 74 recorded in Liber 1 Page 323 by Richard E. Gutekunst Registered Land Surveyor No.7863

Date: October 10, 1972

"Found Fire Clay Post, Set iron on North side."

West 12" Maple 20.29'

S-60°±-E 48" Maple 74.0'

SWly 24" Maple 55.85'

S-50°±-E 18" Ash 15.1'

SWly 12" Ash 15.85'

Source: Certificate of survey recorded in Liber 958 Page 800-801 by Timothy B. VanGieson Registered Land Surveyor No.24621

Date: October 15, 1977

"Found fire clay with 3/4" pipe"

16 nail in 15" Maple N 85° W 20.17'

20 nail & cap in 18" Ash N 45° E 76.92'

20 nail & cap in 60" Maple S 45° E 72.86'

20 nail & cap in 18" Ash S 30° W 24.08'

**SURVEY &
REMONUMENTATION**

MAR 13 2000

SECTION



Mindy Ralily - Jackson Co.

CORREM

2139378

Page: 2 of 2

12/08/1999 11:41A

L-1618 P-1232