

Chairman David E. Eubank  
Date 6-11-97

WEST 1/4 POST, SECTION 23  
FULASKI TOWNSHIP

LAND CORNER RECORDATION CERTIFICATE  
Filing Requirement of Act 74, Mich. P.A. 1970

#2037304  
Liber 1544 Page 373  
Page 1 of 2  
Jackson Co., MI  
Recorded  
06/11/97 11:33A  
Mindy Reilly  
Register of Deeds

For corners in

JACKSON  
(County)

Located in:

Corner Code #

SURVEY &  
REMONUMENTATION

APR 07 1998

SECTION

Register of Deeds Stamp & File Number

1. Public Land Survey T 4 S R 3 W I-8  
T R  
T R  
T R  
2. Property Controlling S T R  
in Section S T R  
3. Miscellaneous S T R  
Property in Sec. S T R  
4. Lot No. , Recorded Plat  
5. Private Claims

DEAN R. GUTEKUNST in a field survey on May 21, 1997  
do hereby certify that under requirements of P.A. 74, Michigan P.A. of 1970, the corner points mentioned in lines 1 and 2 above were in conformance with regulations and rules therefore as required in the current manual of survey instructions of the United States Department of the Interior, Bureau of Land Management or by a decree of a Court of Law and/or that the corner points mentioned in lines 3, 4 and 5 above were in conformance with the rules of the Michigan Board of Land Surveyors or by a Decree of a Court of Law; established, re-established, monumented, re-monumented, recovered, found as expressed below:

NOTE: Not more than 4 corners, all in the same town and range, may be recorded on this certificate.

	A	B	C	D	E	F	G	H	I	J	K	L	M
2	6	5	4	3	2	1							
3													
4	7	8	9	10	11	12							
5													
6	18	17	16	15	14	13							
7													
8	19	20	21	22	23	24							
9													
10	30	29	28	27	26	25							
11													
12	31	32	33	34	35	36							
13													

A. Description of original monument and accessories and/or subsequent restoration:

Original Government Post set by Robert Clark, Jr., Deputy Surveyor, 1825.  
Hickory 6" S 3 1/2 W 23 links (15.18')  
W. Oak 13" N 21 W 47 links (31.02')  
No perpetuation found for the 1880's.

Perpetuation by Fred C. Riley, #377, dated May 2, 1907.  
\* Maple 18" N 16 E 85.8'  
Maple 12" N 69 1/2 E 25.6'

Stone corner, set plowpoint beside it. In line of fence East and


Continued on back,

3. Description of corner evidence found and/or method applied in restoring or reestablishing corner:

Found Stone corner with plow point on East side and capped iron #18658 on North side.  
Corner is approximately 1 1/2' West of center line of Cowan Road (gravel) and 1'± North of fence West and 1 1/2'± South of fence East.

Accepted Stone, as a careful and faithful perpetuation of the position of the original corner, as previously established.

Set a Standard Jackson County Monument to replace the Stone and left Stone buried on the North side of the monument and the plowpoint buried on the South side.

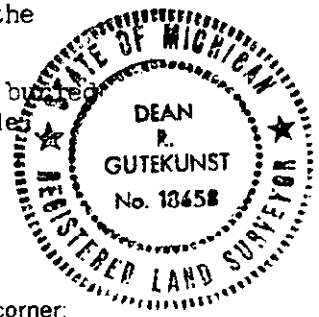

2. Description of monument for corner and accessories established to perpetuate locating the position of the corner:

I-8 T4S, R3W Corner is a 4" diameter X 30" Cast Iron Harrison monument with a brass cap stamped 18658, which is the standard monument for Jackson County.  
\* N 16° E 34" Maple 86.5' Found 40d on West side.  
\*\* N 15° W 20" Maple 82.36' Found 40d on East side.  
\*\*\* S 44° W 13" Hickory 31.47' Found 40d on Northwest side.  
\*\*\*\* S 34° W Double (10" West & 11" East) 36.60' Found 40d on West side of 10".  
S 17° W Quad. W. Oak 68.82' Found nail & washer #28409 on East side 15".  
N 86° E Railroad Tie Corner Post in concrete 28.80' 40d & washer on South side.  
N 86° E Survey marker sign attached to the Railroad Tie Corner post above.

igned by Dean R. Gutekunst  
urveyor's Michigan License No. 18658

Date June 1, 1997