

LAND CORNER RECORDATION CERTIFICATE
Filing Requirement of Act 74, Mich. P.A. 1970


For corners in

**SURVEY &
REMONUMENTATION**

FEB 26 2001

SECTION

KALKASKA Located In: Corner Code #
(County)
2000 REMONUMENTATION
1. Public Land Survey T 25N R 5W J-9
T R
T R
T R
2. Property Controlling S T R
in Section S T R
3. Miscellaneous S T R
Property in Sec. S T R
4. Lot No. , Recorded Plat
5. Private Claims

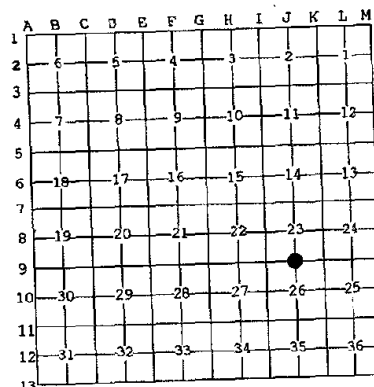

I, EUGENE FARRIER, in a field survey on August 9, 2000 do hereby state that under requirements of P.A. 74, Michigan P.A. of 1970, the corner points mentioned in lines 1 and 2 above were in conformance with regulations and rules therefore as required in the current manual of survey instructions of the United States Department of the Interior, Bureau of Land Management or by a decree of a Court of Law and for that the corner points mentioned in lines 3, 4 and 5 above were in conformance with the rules of the Michigan Board of Land Surveyors or by a Decree of a Court of Law; established, re-established, monumented, recovered, found as expressed below:

NOTE: Not more than 2 corners, all in the same town and range, may be recorded on this certificate.

A. Description of original monument and accessories and/or subsequent restoration:
J-9: 1/4 Cor. Common to Secs. 23 & 26, T25N-R5W, Garfield Township
July 28, 1852 GLO Resurvey by George H. Cannon, set post for corner; Sp. Pine 11" N 66° W 21 links, Sp. Pine 8" S 72° E 35 links.

B. Description of corner evidence found and/or method applied in restoring or reestablishing corner:
J-9: 1/4 Cor. Common to Secs. 23 & 26, T25N-R5W, Garfield Township
Found Pk in centerline E-W Road, set single proportioned between found corners, N 45° W, 56.06' set nail and washer in 5" J. Pine; N 01° W, 40.84' set nail and washer in 5" J. Pine; N 55° E, 53.92' set nail and washer in 5" J. Pine; S 13° E 60.77' set nail and washer in 5" J. Pine;
No G.L.O. witnesses were found.

C. Description of monument for corner and accessories established to perpetuate locating the position of the corner:
J-9: 1/4 Cor. Common to Secs. 23 & 26, T25N-R5W, Garfield Township
Found Pk in centerline E-W Road, set single proportioned between found corners. Replaced with 5/8" iron with brass cap in mon box.
N 45° W, 56.06' set nail and washer in 5" J. Pine
N 01° W, 40.84' set nail and washer in 5" J. Pine
N 55° E, 53.92' set nail and washer in 5" J. Pine
S 13° E 60.77' set nail and washer in 5" J. Pine
Kalkaska County Peer Group accepted the above monument as a careful and faithful reestablishment of the position of the original corner.

Ratified by Peer Group
P.A. 345 - 1990 Kalkaska County
Chairman Eugene Farrier
Date 2-14-01



Signed by Eugene Farrier
Surveyor's Michigan License No. 24594

Date 2-15-01



3026813
Page: 1 of 1
02/15/2001 10:26A
REMON
LB: 6 PG: 142