



Land Corner Recordation Certificate
Authority: 1970 PA 74, MCL 54.205


Surveyor's Name: Joshua R. Davidson Field Survey Date: November 21, 2017
For corner(s) in: Kalkaska County

Original Public Land Survey Corner
S 15, 16, 21, 22 T 25N R 6W Corner Code G7
S T R
S T R
S T R

Property Controlling Corner
S 16 T 25N R 6W Corner Code F6
S T R
S T R
S T R

Property Corner
S T R
S T R
S T R
S T R

Protracted Public Land Survey Corner
S T R
S T R
S T R
S T R

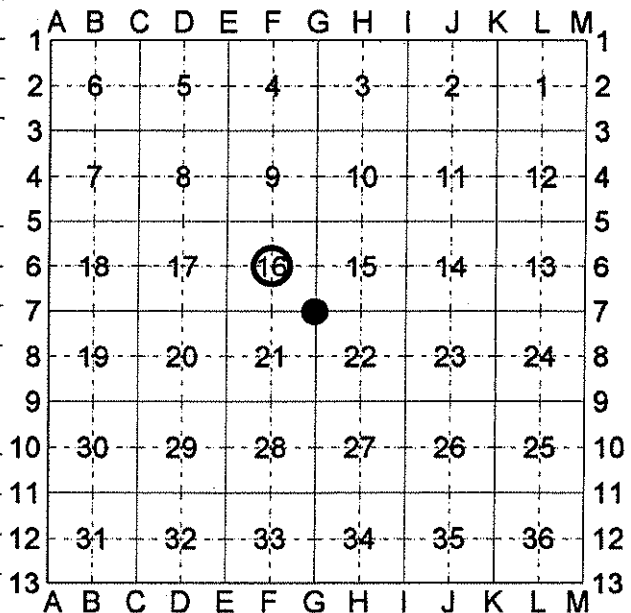

Part A: Corner History

G7 – corner common to sections 15 16 21 & 22 T25N R6W F6 – Center ¼ corner section 16, T25N, R6W

- 1852 – GLO – Cannon – set post corner of sections 15, 16, 21 & 22. – None
1) sp. Pine 7 N32°W 22. 2) sp. Pine 7 S45°E 26.
- 1940 – Marcus Schaaf – field notes, book T25N, R6W, page 42 – NW site plain & SE site possible.
Cor 50 lks N. of county road center. L.E.S. cor N10W 80 lks. –
3) Y. Pine stump 14" N22½°W 1.50
4) J. Pine 9" N16°E 59 ½
5) J. Pine 10" N87°E 63
6) Y. Pine 6" N11½°W 1.18
- 1954 – DNR Corner Record – Dean C. DeLamater, PS# 5778 – This corner was located by Forestry Division survey crew, while making a resurvey of the township. Corner was previously located and perpetuated by Marcus Schaaf, Registered Land Surveyor. Remains of one original B.T. still in place, in poor condition. – 1" pipe with 4" brass cap. –
7) 12" Red Pine N13°W 119 links
8) 12" J. Pine S41°E 150 links

PART A: Continued

G7 – corner common to sections 15 16 21 & 22 T25N R6W

- 1972 – LCRC – L. 1, P. 79 – C. Eugene Ostling, PS
- #12026 – 1" pipe / brass cap –
- 7) 12" R. Pine N13°W 78.54'
- 8) 12" J. Pine S41°E 99.0'

Part B: Surveyor's Report on Perpetuation, Restoration, Reestablishment, or Monumentation of Corner

G7 – corner common to sections 15 16 21 & 22 T25N R6W F6 – Center ¼ corner section 16, T25N, R6W

Found 4" department of conservation brass cap on 1" pipe. Found accessory #7(dead) fitting position of monument. Accepted the position of found 4" department of conservation brass cap on 1" pipe as a careful and faithful perpetuation of the position of the original corner.

Set a stamped 2" aluminum cap on 5/8" X 34" rebar at intersection of ¼ quarter lines of section 16.

Part C: Field Evidence of Perpetuation or Monumentation of Corner


G7 – corner common to sections 15 16 21 & 22 T25N R6W F6 – Center ¼ corner section 16, T25N, R6W

- a 4" department of conservation brass cap on 1" pipe.
- Set blue post 1' North.

- a stamped 2" aluminum cap on 5/8" X 34" rebar.
- Set blue post with location tag 1' Northeast.

N72°E 49.50' to set nail & tag in N. side 7" J. Pine
South 76.81' to set nail & tag in W. side 10" Oak
S20°W 69.47' to set nail & tag in W. side 12" Oak
N59°W 129.62' to set nail & tag in S. side power pole
Southwest 35'± to centerline Fletcher Road

N74°E 27.03' to set nail & tag in N. side 6" J. Pine
S04°E 44.51' to set nail & tag in E. side 8" J. Pine
N64°W 37.10' to set nail & tag in N. side 6" J. Pine
N08°W 16.56' to set nail & tag in E. side 8" J. Pine

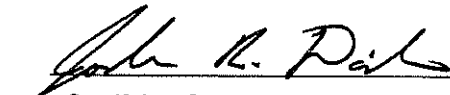

Certifying Surveyor's Name

February 1, 2018

Date

Professional Surveyor's License No.: 46659

Prepared By: Joshua R. Davidson
Department of Natural Resources
8015 Mackinaw Trail
Cadillac, MI 49601

