



8 0 3 3 1 9 5

Tx:4023361

1/24/2014 9:45:00 AM

LAND CORNER RECORDATION CERTIFICATE

Filing Requirement of Act 74, Mich. PA 1970

For Corners In:

Kalkaska

(County)

Located In

Corner Code #

1. Public Land Survey	T		R	
	T		R	
2. Property Controlling in Section	S 25	T 25N	R 7W	4
	S 25	T 25N	R 7W	5
3. Miscellaneous Property in Section	S	T	R	
	S	T	R	

4. Lot No: Recorded Plat:

5. Private Claims:

I, Joshua R. Davidson, in a field survey on September 11, 2013 do hereby state that under requirements of PA 74, Michigan PA of 1970, the corner points mentioned in lines 1 and 2 above were in conformance with regulations and rules therefore as required in the current manual of survey instructions of the United States Department of the Interior, Bureau of Land Management or by a decree of a Court of Law and/or that the corner points mentioned in lines 3, 4 and 5 above were in conformance with the rules of the Michigan Board of Land Surveyors or by a Decree of a Court of Law; established, re-established, monumented, recovered, found as expressed below:

NOTE: Not more than 2 corners, all in the same town and range, may be recorded on this certificate.

DOCUMENT #

3117903

JOANN DEGRAAF

KALKASKA CTY ROD

KALKASKA, MI

RECORDED ON

01/24/2014 09:56 AM

REC FEE: 14.00

PAGES: 1

BK: 3PG: 366

Register of Deeds Stamp & File Number

	A	B	C	D	E	F	G	H	I	J	K	L	M
1													
2	6		5			4		3		2		1	
3													
4	7		8		9		10		11		12		
5													
6	18		17		16		15		14		13		
7													
8	19		20		21		22		23		24		
9													
10	30		29		28		27		26		25		
11													
12	31		32		33		34		35		36		
13													


A. Description of original monument and accessories and/or subsequent restoration:

4 – NW 1/16 corner section 25

5 – CN 1/16 corner section 25

2007 – Unrecorded Survey, File No. 15807 – Dean Farrier,
PS #41098 – set 1/2" rod & cap.

2007 – Unrecorded Survey, File No. 15807 – Dean Farrier,
PS #41098 – set 1/2" rod & cap.

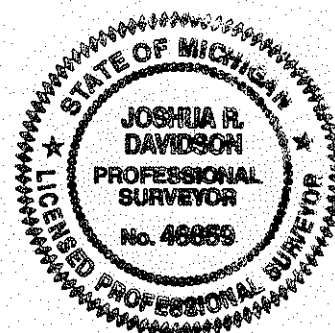

B. Description of corner evidence found and/or method applied in restoring or re-establishing corner:

4 – NW 1/16 corner section 25

5 – CN 1/16 corner section 25

Found no evidence of Farrier iron. Set a stamped 2"
aluminum cap on a 5/8" x 34" rebar per standard BLM
procedure.

Found no evidence of Farrier iron. Set a stamped 2"
aluminum cap on a 5/8" x 34" rebar per standard BLM
procedure.

C. Description of monument for corner and accessories established to perpetuate locating the position of the corner:

4 – a stamped 2" aluminum cap on 5/8" x 34" rebar

5 – a stamped 2" Aluminum Cap on 5/8" rebar

N56°E 11.75' to set nail & tag in SE. side 17" R. Pine
S27°E 11.43' to set nail & tag in SW. side 20" R. Pine
S75°W 13.20' to set nail & tag in SE. side 13" R. Pine
N52°W 30.68' to set nail & tag in SW. side 14" R. Pine
Set blue post with location tag 1' Southwest

N38°E 50.94' to set nail & tag in NW. side 8" R. Pine
S35°E 44.25' to set nail & tag in SW. side 10" R. Pine
S05°W 44.53' to set nail & tag in W. side 16" Cherry
S65°W 79.77' to set nail & tag in SE. side twin 10" R. Maple
Set blue post with location tag 1' Southeast.

Signed by:

Date:

1-22-2014

Surveyor's Michigan License No.:

46659