

LAND CORNER RECORDATION CERTIFICATE
Filing Requirement of Act 74, Mich. P.A. 1970

For corners in

KALKASKA Located in: Corner Code #
(County)
1998 REMONUMENTATION
1. Public Land Survey T. 25N R. 8W K-5
T. R.
T. R.
T. R.
2. Property Controlling S. T. R.
in Section S. T. R.
3. Miscellaneous S. T. R.
Property in Sec. S. T. R.

SURVEY &
REMONUMENTATION

FEB 22 1999

SECTION

Register of Deeds Stamp & File Number

4. Lot No. , Recorded Plat
5. Private Claims

I, EUGENE FARRIER, in a field survey on October 26, 1998 do hereby state that under requirements of P.A. 74, Michigan P.A. of 1970, the corner points mentioned in lines 1 and 2 above were in conformance with regulations and rules therefore as required in the current manual of survey instructions of the United States Department of the Interior, Bureau of Land Management or by a decree of a Court of Law and for that the corner points mentioned in lines 3, 4 and 5 above were in conformance with the rules of the Michigan Board of Land Surveyors or by a Decree of a Court of Law; established, re-established, monumented, recovered, found as expressed below:

NOTE: Not more than 2 corners, all in the same town and range, may be recorded on this certificate.

	A	B	C	D	E	F	G	H	I	J	K	L
1												
2	6		5		4		3		2		1	
3												
4	7		8		9		10		11		12	
5												
6	18		17		16		15		14		13	
7												
8	19		20		21		22		23		24	
9												
10	30		29		28		27		26		25	
11												
12	31		32		33		34		35		36	
13												

A. Description of original monument and accessories and/or subsequent restoration:

K-5: Sec. Cor. Common to Secs. 11, 12, 13 & 14, T25N-R8W, Springfield Township

1852, GLO. Sub. resurvey by V.W. Cankin D.S.; set post at corner; Sugar 6", S78°W, 19 Lks. (12.54'); Hemlock 24", N55°E, 5 Lks. (3.30') S. edge small lake, North, 7.30 Ch. (481.8'); W. Edge small lake, East 14.36 Ch. (947.76')

1890, Road survey by E. Mosher CS., Co. Survey Bk. Pg. 3; measured from fd. cor. no/acc.

1909, 1913, 1915, 1918, Sec. Sub. Survey by W.S. Merrill CS., FB # 24, Pg. 1, & Co. Survey Bk. Pg. 51, stone cor. placed many years ago where Gov't survey cor. was found.

10-26-98, E. Farrier, found 3/4" iron pipe in CL North-South road & 11' North of East-West road

B. Description of corner evidence found and/or method applied in restoring or reestablishing corner:

K-5: Sec. Cor. Common to Secs. 11, 12, 13 & 14, T25N-R8W, Springfield Township

Found and accepted 3/4" iron pipe in CL North-South road & 11' North of East-West Road (as shown in previous Cert. of Survey) Pulled and set 5/8" X 18" re-bar w/brass cap in mon. box

No G.L.O. witnesses were found.

Kalkaska County Peer Group accepted the above monument as the best available evidence of the position of the original corner.

Ratified by Peer Group

P.A. 345 - 1990 Kalkaska County

Chairman Eugene Farrier

Date 2-2-99

C. Description of monument for corner and accessories established to perpetuate locating the position of the corner:

K-5: Sec. Cor. Common to Secs. 11, 12, 13 & 14, T25N-R8W, Springfield Township

Found and accepted 3/4" iron pipe in CL North-South road & 11' North of East-West Road. Pulled and set 5/8" X 18" re-bar w/brass cap in mon. box

N50°E, 44.46' - Power pole, set nail & washer


N45°W, 65.13' - 10" Poplar, set nail & washer

S60°W, 70.50' - 14" S. Pine, set nail & washer

S25°E, 90.55' - 8" R. Pine, set nail & washer

Signed by Eugene Farrier
Michigan License No. 24594

Date 2-8-99

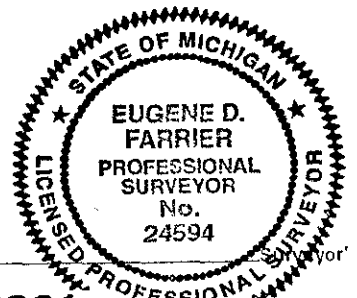

3012681
Page: 1 of 1
02/10/1999 08:40A
LB: 5 PG: 336

REVISIONS, JAN. 28, 197
REVISED MAY 14, 197
REVISED JAN. 197
REVISED OCT., 197