

SURVEY &
REMONUMENTATION

FEB 13 1998

LAND CORNER RECORDATION CERTIFICATE
Filing Requirement of Act 74, Mich. P.A. 1970

For corners in

KALKASKA SECTION
(County)

Located In:

Corner Code #

1997 REMONUMENTATION

1. Public Land Survey

T. 26N R. 8W

T. 25N R. 8W

M-13

M-1

T. R.

T. R.

2. Property Controlling
in Section

S. T. R.

S. T. R.

3. Miscellaneous
Property in Sec.

S. T. R.

S. T. R.

Register of Deeds Stamp & File Number

4. Lot No. , Recorded Plat

5. Private Claims

EUGENE FARRIER, in a field survey on OCTOBER 29, 1997

I do hereby state that under requirements of P.A. 74, Michigan P.A. of 1970, the corner points mentioned in lines 1 and 2 above were in conformance with regulations and rules therefore as required in the current manual of survey instructions of the United States Department of the Interior, Bureau of Land Management or by a decree of a Court of Law and /or that the corner points mentioned in lines 3, 4 and 5 above were in conformance with the rules of the Michigan Board of Land Surveyors or by a Decree of a Court of Law; established, re-established, monumented, recovered, found as expressed below:

NOTE: Not more than 2 corners, all in the same town and range, may be recorded on this certificate.

	A	B	C	D	E	F	G	H	I	J	K	L	M
1													
2		6		5		4		3		2		1	
3													
4		7		8		9		10		11		12	
5													
6		18		17		16		15		14		13	
7													
8		19		20		21		22		23		24	
9													
10		30		29		28		27		26		25	
11													
12		31		32		33		34		35		36	
13													

A. Description of original monument and accessories and/or subsequent restoration:

M-13: Southeast Cor. Sec. 36, T26N-R8W, Boardman Township, & Northeast Cor. Sec.

1, T25N-R8W, Springfield Township, (M-1)

1852, GLO resurvey, used cor., 18" Beech N45W, 50, 24" Sugar N17E, 42, 18" Sugar S50W, 47, 10" Ironwood S58E, 07

07-20-1911, W.S. Merrill, Co. Surveyor, Fd. Iron

04-28-1992, B.M. Jones #23514, Cert. Survey, Fd. PK nail, w/accessories, Lib. 4, Pg. 981

09-08-1992, Grand Traverse Survey Co., Cert. Survey, Fd. 5/8" rerod w/accessories

B. Description of corner evidence found and/or method applied in restoring or reestablishing corner:

M-13: Southeast Cor. Sec. 36, T26N-R8W, Boardman Township, & Northeast Cor. Sec. 1, T25N-R8W, Springfield Township, (M-1)

Fd. 1/2" x 18" rebar (cannot read cap) in CL Puffer Rd. & 5' South CL Inman Rd. to West. Pulled and replaced with 5/8" x 18" rebar w/brass cap in mon. box. No GLO witnesses were fd. The Kalkaska Co. Peer group approved & accepted the above monument as the best available evidence of the position of the original corner.

Ratified by Peer Group
P.A. 345 - 1990 Kalkaska County

Chairman Eugene Farrier

Date 1-29-98

C. Description of monument for corner and accessories established to perpetuate locating the position of the corner:

M-13: Southeast Cor. Sec. 36, T26N-R8W, Boardman Township, & Northeast Cor. Sec. 1, T25N-R8W, Springfield Township, (M-1)

Fd. 1/2" x 18" rebar (cannot read cap) in CL Puffer Rd. & 5' South CL Inman Rd. to West. Pulled and replaced with 5/8" x 18" rebar w/brass cap in mon. box.


Fd. Nail S65W cor. Fence post, 39.74'

Fd. Nail N55W P.Pole, 79.70'

Set nail & tag N35E, Serv. Pole, 49.82'

Fd. Nail S67E, 36" Maple, 30.88'

South Standard Co. Mon., 279.20' (Closing corner)

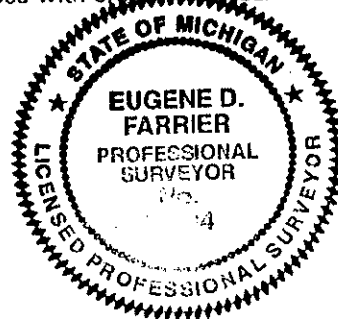

Signed by Eugene Farrier

Date 2-3-98

Surveyor's Michigan License No. 24594



3004888

Page: 1 of 1

02/04/98 11:22/

LB: 5 PG: 292

FORM APPROVED BY MICHIGAN STATEBOARD OF PROFESSIONAL SURVEYORS, JAN. 28, 1971
REVISED MAY 14, 1976
REVISED JAN., 1983
REVISED OCT., 199