

LAND CORNER RECORDATION CERTIFICATE

Filing Requirement of Act 74, Mich. PA 1970

For Corners In:

Kalkaska

(County)

Located In

Corner Code #

1. Public Land Survey	T	26N	R	5W	G7
	T		R		
2. Property Controlling in Section	S	T	R		
	S	T	R		
3. Miscellaneous Property in Section	S	T	R		
	S	T	R		

4. Lot No: Recorded Plat:

5. Private Claims:

I, Joshua R. Davidson, in a field survey on October 15, 2014 do hereby state that under requirements of PA 74, Michigan PA of 1970, the corner points mentioned in lines 1 and 2 above were in conformance with regulations and rules therefore as required in the current manual of survey instructions of the United States Department of the Interior, Bureau of Land Management or by a decree of a Court of Law and/or that the corner points mentioned in lines 3, 4 and 5 above were in conformance with the rules of the Michigan Board of Land Surveyors or by a Decree of a Court of Law; established, re-established, monumented, recovered, found as expressed below:

NOTE: Not more than 2 corners, all in the same town and range, may be recorded on this certificate.

Register of Deeds Stamp & File Number

A	B	C	D	E	F	G	H	I	J	K	L	M
1												
2	6		5		4		3		2		1	
3												
4	7		8		9		10		11		12	
5												
6	18		17		16		15		14		13	
7												
8	19		20		21		22		23		24	
9												
10	30		29		28		27		26		25	
11												
12	31		32		33		34		35		36	
13												

A. Description of original monument and accessories and/or subsequent restoration:

G7 – corner common to sections 15, 16, 21 & 22, T26N, R5W

- 1852 – GLO Resurvey – G. Cannon – Set post corner of sec. 15, 16, 21 & 22 – 1) W Pine 14" N69°W 6, 2) W Pine 14" S62°E 25
- 1913 – Fargo Eng. – Found one US Witness and remains of other. Found remains of old stake. Set 1" iron pipe and crockery.
- 3) B. Oak 7" S26°W 0.46½, 4) W Pine stump 16" N24½°E 0.98½
- 1957 – DNR Survey Map of T26N R5W, – K.J. Ostling – ¾" pipe by Consumers Power Co.
- 1978 – Consumer's Power Co. Survey drawing #S-F17406 – D. A. Ankrom – Found ¾" iron & crockery, 5) 12" Triple Oak S26°E 29.61', 6) 14" Oak N80½°W 41.46', 4) stump N24½°E 64.13'
- 2011 – LCRC L. 3, P. 313, – C. McVean, PS, #39088 – Found Fargo ¾" X 2.3' long hooked end pipe and butter dish. Replaced ¾" Fargo pipe with stamped 4" DNR Alum. Cap on 1" x 36" galv. iron pipe encased in 4" X12" PVC filled with concrete. Reset butter dish at base of monument as memorial. East 0.9' to face of 6" X 6" treated wood Post. Set Orange carsonite Post 1' North. –
- 7) N47°E 7.17' to set nail & tag at found nail in SE side 9" W Pine, 8) S36°E 10.56' to set nail & tag at found nail in SW side 12" Oak, 5) S24°E 29.85' to set nail & tag in E side Triple 20", 19" & 16" Oak, 9) S16°W 22.42' to set nail & tag at found nail in E side 7" R. Maple, 10) S86°W 28.31' to set nail & tag at found nail in N side Twin 10" W Pine, 6) N79°W 41.12' to set nail & tag at found nail in N side 25" Oak.

B. Description of corner evidence found and/or method applied in restoring or re-establishing corner:


G7 – corner common to sections 15, 16, 21 & 22, T26N, R5W

Found 4" DNR aluminum cap on 1" galvanized iron pipe encased in 4" PVC filled with concrete per the 2011 LCRC. Found witnesses #6, #7, #8, #9 & #10 in good condition and remains of witnesses #2 & #4. Witness #5 was found blown down. Found 4" DNR aluminum cap on 1" galvanized iron pipe accepted as a careful and faithful perpetuation of the position of the original corner.

C. Description of monument for corner and accessories established to perpetuate locating the position of the corner:

G7 – A stamped 4" DNR aluminum cap on 1" galvanized iron pipe encased in 4" X12" PVC filled with concrete. East 0.9' to face of 6" X 6" treated wood Post. Orange carsonite Post 1' North.

- N47°E 7.08' to found nail & tag in SE side 9" W Pine (#7)
- S36°E 10.56' to found nail & tag in SW side 12" Oak (#8)
- S16°W 22.42' to found nail & tag in E side 7" R. Maple (#9)
- S86°W 28.31' to found nail & tag in N side Twin 10" W Pine (#10)
- N79°W 41.12' to found nail & tag in N side 25" Oak (#6)

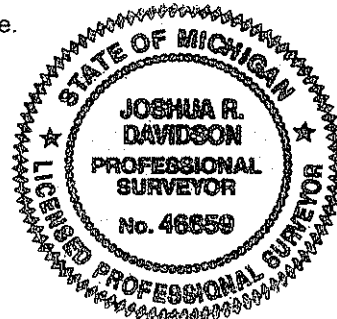

Signed by:

Joshua R. Davidson

Date:

Dec. 16, 2014

Surveyor's Michigan License No.:

46659