



8 0 2 3 2 7 6

Tx:4016447

11/29/2012 1:00:00 PM

LAND CORNER RECORDATION CERTIFICATE

Filing Requirement of Act 74, Mich. PA 1970

For Corners In:

Kalkaska

(County)

Located In

Corner Code #

1. Public Land Survey	T	26N	R	6W	H9
	T		R		
2. Property Controlling in Section	S		T		R
	S		T		R
3. Miscellaneous Property in Section	S		T		R
	S		T		R

4. Lot No: _____ Recorded Plat: _____

5. Private Claims: _____

I, Joshua R. Davidson, in a field survey on March 1, 2012 do hereby state that under requirements of PA 74, Michigan PA of 1970, the corner points mentioned in lines 1 and 2 above were in conformance with regulations and rules therefore as required in the current manual of survey instructions of the United States Department of the Interior, Bureau of Land Management or by a decree of a Court of Law and/or that the corner points mentioned in lines 3, 4 and 5 above were in conformance with the rules of the Michigan Board of Land Surveyors or by a Decree of a Court of Law; established, re-established, monumented, recovered, found as expressed below:

NOTE: Not more than 2 corners, all in the same town and range, may be recorded on this certificate.

DOCUMENT #

3111418

JOANN DEGRAAF

KALKASKA CTY ROD

KALKASKA, MI

RECORDED ON


11/29/2012 1:31 PM

REC FEE: 14.00

PAGES: 1

BK: 3PG: 342

Register of Deeds Stamp & File Number

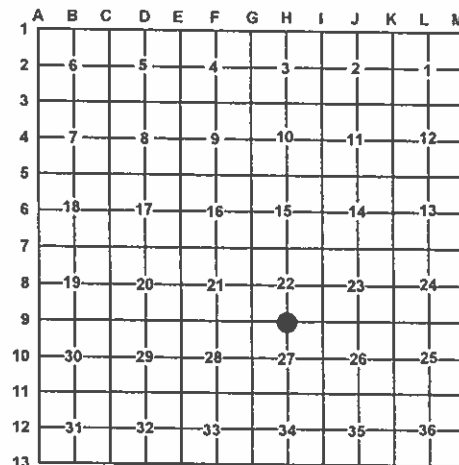

A. Description of original monument and accessories and/or subsequent restoration:

H9 – 1852 – GLO, G. Cannon – Set ¼ sec. post

1) Hemlock 10" N40°E 10

2) Hemlock 6" S60°W 21

1889 – County Surveyor, E. Mosher – Section 27 survey. Shows corner and distance south

1959 – DNR corner record, K. J. Ostling, PS #10068. Set corner by proportionate measurement – midpoint, on line between section corners. Hemlock government BT's gone, and no definite original evidence.

Set 1" pipe with 4" Brass Cap

3) 8" Maple S65°E 91 ½ L.

4) 6" Cherry S31°W 110 ½ L.

5) Center of trail South 20 L.

B. Description of corner evidence found and/or method applied in restoring or re-establishing corner:

H9 – ¼ corner common to sections 22 & 27, T26N, R6W. Found broken 4" Brass Department of Conservation (DOC) cap on 1" pipe per the 1959 Ostling corner record, 14'± North of 2-track centerline. Stumps of witnesses #3 & #4 were found fitting position. Found no GLO evidence. Replaced broken 4" Brass DOC cap and 1" pipe with a stamped 4" DNR aluminum cap on a 1" X 36" galvanized iron pipe and is accepted as a careful and faithful reestablishment of the position of the original corner.

C. Description of monument for corner and accessories established to perpetuate locating the position of the corner:

H9 – Stamped 4" DNR aluminum cap on 1" x 36" galvanized iron pipe.

N76°E 44.76 to set nail & tag in N. side 5" Fir

S46°W 60.38' to set nail & tag in NW. side 7" Cherry

N47°W 63.03' to set nail & tag in NE. side 4" Jack Pine

N03°W 93.76' to set nail & tag in E. side 8" Jack Pine

Set blue Carsonite post 1' North



Signed by:

Date:

11-29-2012

Surveyor's Michigan License No.:

46659