



8 0 2 3 2 8 4

Tx: 4016447

11/29/2012 1:00:00 PM

LAND CORNER RECORDATION CERTIFICATE

Filing Requirement of Act 74, Mich. PA 1970

For Corners In:

Kalkaska

(County)

Located in

Corner Code #

1. Public Land Survey	T		R	
	T		R	
2. Property Controlling in Section	S 22	T 26N	R 6W	1
	S	T	R	
3. Miscellaneous Property in Section	S	T	R	
	S	T	R	

4. Lot No: Recorded Plat:

5. Private Claims:

I, Joshua R. Davidson, in a field survey on January 9, 2012 do hereby state that under requirements of PA 74, Michigan PA of 1970, the corner points mentioned in lines 1 and 2 above were in conformance with regulations and rules therefore as required in the current manual of survey instructions of the United States Department of the Interior, Bureau of Land Management or by a decree of a Court of Law and/or that the corner points mentioned in lines 3, 4 and 5 above were in conformance with the rules of the Michigan Board of Land Surveyors or by a Decree of a Court of Law; established, re-established, monumented, recovered, found as expressed below:

NOTE: Not more than 2 corners, all in the same town and range, may be recorded on this certificate.

DOCUMENT #

3111426

JOANN DEGRAAF

KALKASKA CTY ROD

KALKASKA, MI

RECORDED ON


11/29/2012 1:31 PM

REC FEE: 14.00

PAGES: 1

BK: 3PG: 350

Register of Deeds Stamp & File Number

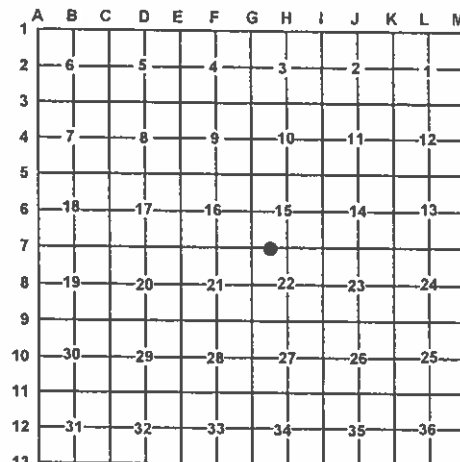

A. Description of original monument and accessories and/or subsequent restoration:

1 - W 1/16 corner common to sections 15 & 22.

1959 - DNR Corner record - K. J. Ostling, PS #10068. This corner was established by proportionate measurement by Forestry Division survey crew while making a partial resurvey of this township. Corner was set to identify state land boundary. Falls about 40 links North of centerline of E-W county road. Set 1" X 24" pipe.
6" Cedar S5°E 74½ Links.

B. Description of corner evidence found and/or method applied in restoring or re-establishing corner:

1 - W 1/16 corner common to Sections 15 & 22.

Found Ostling pipe. Rejected position set by Ostling because the position of G7 and H7 used to establish the corner was rejected by remonumentation. Set a stamped 2" aluminum cap on 5/8" X 34" rebar per BLM standard procedure, using the remonumentation position of G7 & H7.

C. Description of monument for corner and accessories established to perpetuate locating the position of the corner:

1 - W 1/16 corner common to Sections 15 & 22.

Set a stamped 2" Aluminum Cap on 5/8" X 34" rebar.

N15°13'E 13.31' to found 1" Pipe (Ostling)
N88°E 124.83' to set nail & tag in top center 4" X 6" guardrail post
S33°W 48.05' to set nail & tag in NW. side 7" Ash
N25°W 37.45' to set nail & tag in SW. side 4" Elm
Set blue Carsonite post with location tag 44.6' South

Signed by:

Surveyor's Michigan License No.:

46659

Date:

11-29-2012

