



8 0 2 3 2 7 4

Tx:4016447

11/29/2012 1:00:00 PM

34

LAND CORNER RECORDATION CERTIFICATE

Filing Requirement of Act 74, Mich. PA 1970

For Corners In:

Kalkaska

(County)

Located In

Corner Code #

1. Public Land Survey

T 26N R 6W G9

2. Property Controlling
in Section

S T R

S T R

3. Miscellaneous
Property in Section

S T R

S T R

4. Lot No:

Recorded Plat:

5. Private Claims:

I, Joshua R. Davidson, in a field survey on April 2, 2012 do hereby state that under requirements of PA 74, Michigan PA of 1970, the corner points mentioned in lines 1 and 2 above were in conformance with regulations and rules therefore as required in the current manual of survey instructions of the United States Department of the Interior, Bureau of Land Management or by a decree of a Court of Law and/or that the corner points mentioned in lines 3, 4 and 5 above were in conformance with the rules of the Michigan Board of Land Surveyors or by a Decree of a Court of Law; established, re-established, monumented, recovered, found as expressed below:

NOTE: Not more than 2 corners, all in the same town and range, may be recorded on this certificate.

Register of Deeds Stamp & File Number

DOCUMENT #

3111416

JOANN DEGRAAF

KALKASKA CTY ROD

KALKASKA, MI


RECORDED ON

11/29/2012 1:31 PM

REC FEE: 14.00

PAGES: 1

BK: 3PG: 340

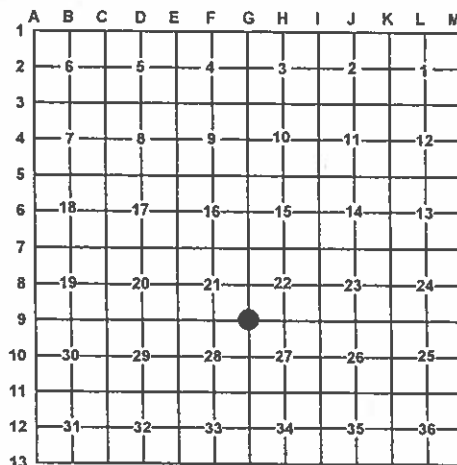

A. Description of original monument and accessories and/or subsequent restoration:

G9 – 1852 – G. Cannon – set post cor. 21-22-27-28

1) Balsam 10" S30°E 14

2) Cedar 12 N35°W 4

- 1959 – DNR Corner Record – K.J. Ostling, PS #10068 – This corner was restored by Forestry Division survey crew while completing a partial resurvey of this township. Set corner at government record from NW government BT, a 14" cedar which was down but has half up upper face intact with plain marks. This position falls 2 links west of another large Cedar which was blazed on 4 sides about 60 years ago. Could not find post since it falls in fairly dry soil in roots of large cedar. A very good specimen of original survey evidence. Set 1" pipe with 4" Brass Cap

3) 8" Cedar N28°W 75 L.

4) 14" Cedar S80°W 47 L.

5) 14" Cedar S80°E 2 L.

B. Description of corner evidence found and/or method applied in restoring or re-establishing corner:

G9 – Section Corner common to Sections 21, 22, 27 & 28, T26N, R6W - Found 4" Department of Conservation (DOC) brass cap on 1" pipe, and witnesses #3, #4 & #5 fitting position per the 1952 DeLaMater corner record. DOC brass monument accepted as a careful and faithful perpetuation of the position of the original corner.

C. Description of monument for corner and accessories established to perpetuate locating the position of the corner:

G9 – Found 4" Department of Conservation (DOC) Brass Cap on 1" pipe.

S75°E 2.06' to set nail & tag in SW. side 16" Cedar (#5)

S77°W 31.35' to set nail & tag in S. side 14" Cedar (#4)

N28°W 48.76' to set nail & tag in SW. side 10" Cedar (#3)

N07°W 75.30' to set nail & tag in E. side 22" Hemlock

Set Blue carsonite post 1' West.

Signed by:

Date:

11-29-2012

Surveyor's Michigan License No.:

46659

