



8 0 2 3 2 6 8

Tx:4016447

11/29/2012 1:00:00 PM

LAND CORNER RECORDATION CERTIFICATE

Filing Requirement of Act 74, Mich. PA 1970

DOCUMENT #

3111410

JOANN DEGRAAF

KALKASKA CTY ROD

KALKASKA, MI

RECORDED ON

11/29/2012 1:31 PM

REC FEE: 14.00

PAGES: 1

BK: 3PG: 334

For Corners In:

Kalkaska

(County)

Located In

Corner Code #


1. Public Land Survey	T	26N	R	6W	D9
	T		R		
2. Property Controlling in Section	S	T	R		
	S	T	R		
3. Miscellaneous Property in Section	S	T	R		
	S	T	R		

4. Lot No: _____ Recorded Plat: _____

5. Private Claims: _____

I, Joshua R. Davidson, in a field survey on February 13, 2012 do hereby state that under requirements of PA 74, Michigan PA of 1970, the corner points mentioned in lines 1 and 2 above were in conformance with regulations and rules therefore as required in the current manual of survey instructions of the United States Department of the Interior, Bureau of Land Management or by a decree of a Court of Law and/or that the corner points mentioned in lines 3, 4 and 5 above were in conformance with the rules of the Michigan Board of Land Surveyors or by a Decree of a Court of Law; established, re-established, monumented, recovered, found as expressed below:

NOTE: Not more than 2 corners, all in the same town and range, may be recorded on this certificate.

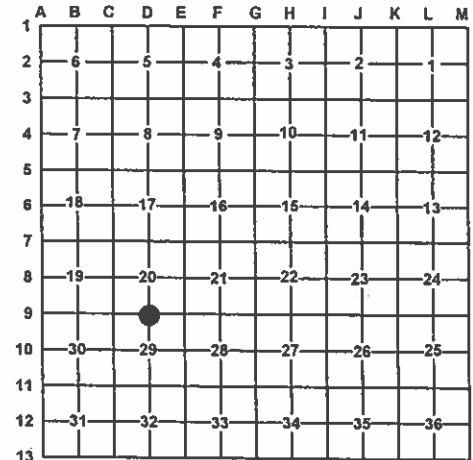

A. Description of original monument and accessories and/or subsequent restoration:

D9 – 1852 – GLO – G. Cannon – set ¼ sec. post

1) Maple 12" N55°W 2

2) Tamarack 10" S65°E 30

1885 – CSR – E. Mosher – No corner description given.

1901 – CSR – W. S. Merrill – Fieldbook #20, P. 69 surveyed for highway. Found old witness marked new.

3) Cedar 10" S19°E 30 feet

4) B. Ash 8" N21°W 15¾ feet

B. Description of corner evidence found and/or method applied in restoring or re-establishing corner:

D9 – ¼ corner common to sections 20, & 29, T26N, R6W. Searched calculated position in tag alder swamp. Dug an 8" X 4" area in search of stake. No GLO or county surveyor evidence found. Set 4" DNR Aluminum cap on 1" X 5' galvanized iron pipe online and double the distance between C9 and found W1/16 corner. Distance West measures 2645.32'-Grid compares to 2645.28'-Merrill, 2653.86'-GLO. Distance East measures 2646.84'-grid (2653.86'-GLO). DNR monument accepted as a careful and faithful reestablishment of the position of the original corner.

C. Description of monument for corner and accessories established to perpetuate locating the position of the corner:

D9 – Set 4" DNR Aluminum cap on 1" X 5' galvanized iron pipe.

N57°E 30.60' to set ½" X 18" rebar

S23°E 35.82' to set ½" X 18" rebar

S35°W 32.16' to set ½" X 24" rebar

N47°W 25.46' to set ½" X 18" rebar

Set blue carsonite post 1' East



Signed by:

Date:

11/29/2012

Surveyor's Michigan License No.:

46659