

SURVEY &  
REMONUMENTATION

MAR 21 1997

LAND CORNER RECORDATION CERTIFICATE 97 JAN 31 PM 3:19  
COMMISSION Filing Requirement of Act 74, Mich. P.A. 1970

For corners in

KALKASKA

(County)

Located In:

Corner Code =#

1996 REMONUMENTATION

1. Public Land Survey

T 26N R 7W

C-5

2. Property Controlling  
in Section

S T R

3. Miscellaneous  
Property in Sec.

S T R

4. Lot No. , Recorded Plat

5. Private Claims

Register of Deeds Stamp & File Number

I, EUGENE FARRIER, in a field survey on July 1, 19 96, do hereby certify that under requirements of P.A. 74, Michigan P.A. of 1970, the corner points mentioned in lines 1 and 2 above were in conformance with regulations and rules therefore as required in the current manual of survey instructions of the United States Department of the Interior, Bureau of Land Management or by a decree of a Court of Law and/or that the corner points mentioned in lines 3, 4 and 5 above were in conformance with the rules of the Michigan Board of Land Surveyors or by a Decree of a Court of Law; established, re-established, monumented, re-monumented, recovered, found as expressed below:

**NOTE: Not more than 4 corners, all in the same town and range, may be recorded on this certificate.**

A. Description of original monument and accessories and/or subsequent restoration:

C-05: Cor. common to Sec. 7, 8, 17, & 18, T26N-R7W, Orange Township 1849, GLO resurvey, set Hemlock post. 12" Hemlock S86W 27, 14" Beech S18E 20.

May 20, 1880, G.A. Leinpert, Co. Surveyor, used cor. no accessories.

Feb 28, 1885, E. Mosher, Co. Surveyor, used cor. no accessories.

May 05, 1903, W.S. Merrill, Co. Surveyor, used cor. no accessories.

March 1947, G.A. Shadke, fd. large stone split in three ways matched N&S & E&W set iron stake. No accessories.

10-20-1967, revised G.A. Shadke survey by Uno A. Suomela

Nov 29, 1973, LCRC Liber 1 Pg. 289.

11-17-1973, J.L. Fletcher, fd. 2"x1/2" iron bar. Liber 1 pgs. 524-530 of Survey.

05-20-1977, J.L. Fletcher, fd. 2"x1/2" iron bar. Liber 2 pgs. 2 of Survey.

06-08-1977, LCRC Liber 2 pg. 12.

11-10-1987, E.D. Farrier, Survey #14289, fd. 2"x1/2" iron w/ accessories.

01-28-1988, Rd. Comm. records, pointed rock & iron stake w/ accessories.

05-09-1988, E.D. Farrier, Survey #5588, fd. 2"x1/2" iron w/ accessories.

06-03-1988, LCRC Liber 2 pg. 357.

08-17-1989, E.D. Farrier, Survey #14089 & #14189, fd. 2"x1/2" iron w/ accessories.

B. Description of corner evidence found and/or method applied in restoring or reestablishing corner:

C-05: Cor. common to Sec. 7, 8, 17, & 18, T26N-R7W, Orange Township Found 2" x 1/2" x 3' angle iron. Pulled & Set 5/8" x 18" re-rod w/ Brass cap 0.5' below road surface, cor falls 3' South & 2' West of centerline intersection of Bass rd. & Ludlow rd. No G.L.O. witnesses were found. The Kalkaska Co. peer group approved & accepted the above monument as a careful and faithful perpetuation of the position of the original corner.

C. Description of monument for corner and accessories established to perpetuate locating the position of the corner:

C-05: Cor. common to Sec. 7, 8, 17, & 18, T26N-R7W, Orange Township Found 2" x 1/2" x 3' iron. Pulled & Set 5/8" x 18" re-rod w/ Brass cap 0.5' below road surface, cor falls 3' South & 2' West of centerline intersection of Bass rd. & Ludlow rd.

Set nail & tag N45E, 5" W. Birch (clump) 46.37'

Set nail & tag S40E, 3"x3" Wood Post (Tel. Riser) 50.09'

S87W Top Face 2" steel fence post, 49.42'

Set nail & tag N50W, Power Pole, 101.64'

Signed by

Eugene Farrier  
24594

Date 1-30-97

Surveyor's Michigan License No.

Ratified by Peer Group  
P.A. 345 - 1990 Kalkaska County

Chairman Eugene Farrier


Date 1-21-97

LIBER 5 PAGE 186

KALKASKA COUNTY, MICHIGAN  
RECEIVED

Joan Hall  
REG. OF DEEDS

	A	B	C	D	E	F	G	H	I	J	K	L
2	6		5		4		3		2		1	
3												
4	7		8		9		10		11		12	
5												
6	18		17		16		15		14		13	
7												
8	19		20		21		22		23		24	
9												
10	30		29		28		27		26		25	
11												
12	31		32		33		34		35		36	
13												

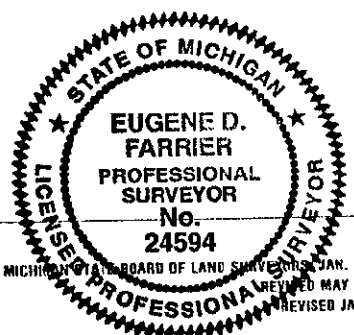

FORM APPROVED BY MICHIGAN BOARD OF LAND SURVEYORS, JAN. 28, 1993  
REVISED MAY 14, 1993  
REVISED JAN., 1993