

SURVEY &
REMONUMENTATION

FEB 13 1998

SECTION

LAND CORNER RECORDATION CERTIFICATE
Filing Requirement of Act 74, Mich. P.A. 1970

For corners in

KALKASKA
(County)

Located In:

Corner Code #

1997 REMONUMENTATION

1. Public Land Survey

T.26N R.7W E-10

T. R.

T. R.

T. R.

2. Property Controlling
in Section

S. T. R.

S. T. R.

3. Miscellaneous

S. T. R.

Property in Sec.

S. T. R.

Register of Deeds Stamp & File Number

4. Lot No. , Recorded Plat

5. Private Claims

I, EUGENE FARRIER, in a field survey on NOVEMBER 21, 1997

do hereby state that under requirements of P.A. 74, Michigan P.A. of 1970, the corner points mentioned in lines 1 and 2 above were in conformance with regulations and rules therefore as required in the current manual of survey instructions of the United States Department of the Interior, Bureau of Land Management or by a decree of a Court of Law; and /or that the corner points mentioned in lines 3, 4 and 5 above were in conformance with the rules of the Michigan Board of Land Surveyors or by a Decree of a Court of Law; established, re-established, monumented, recovered, found as expressed below:

NOTE: Not more than 2 corners, all in the same town and range, may be recorded on this certificate.

	A	B	C	D	E	F	G	H	I	J	K	L	M
1													
2	6			5		4		3		2		1	
3													
4	7			8		9		10		11		12	
5													
6	18			17		16		15		14		13	
7													
8	19			20		21		22		23		24	
9													
10	30			29		28		27		26		25	
11													
12	31			32		33		34		35		36	
13													

A. Description of original monument and accessories and/or subsequent restoration:

E-10: Cor. Common to Sec. 28 & 29, T26N-R7W Orange Twp.

1849, Resurvey, corner in lake, no accessories

05-21-1965, Plat of "Twenty Eight Lakes Park", noted corner, no accessories

Jan. 1977, DNR map, computed cor. no accessories

10-3-1997, Farrier Surveying, set 1" dia. iron pipe in lake, w/accessories

B. Description of corner evidence found and/or method applied in restoring or reestablishing corner:

E-10: Cor. Common to Sec. 28 & 29, T26N-R7W Orange Twp.

Set 1" iron pipe, placed aluminum cap on pipe (in lake). The Kalkaska Co. peer group approved and accepted the above monument as a careful and faithful reestablishment of the position of the original corner.

Approved by Peer Group
A. 345-1990 Kalkaska County

Chairman Eugene Farrier
Date 1-29-98

C. Description of monument for corner and accessories established to perpetuate locating the position of the corner:

E-10: Cor. Common to Sec. 28 & 29, T26N-R7W Orange Twp.


Set 1" iron pipe, placed aluminum cap on pipe (in lake).

S89°59'W conc. mon. 25' West of water, 138.15'

S89°59'W conc. mon. 331.78'

N00°01'37"E set 1/2" iron & cap #24594, 30' from water on Section line meander cor., 283.48'

S00°01'37"W fd. iron & cap #24594 20' South of edge of water on Section line, 450.39

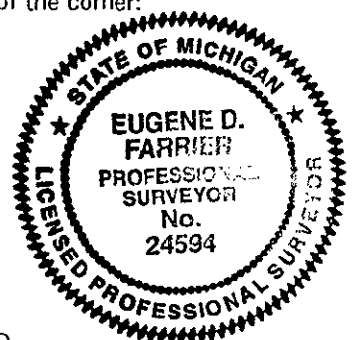

Signed by Eugene Farrier
Surveyor's Michigan License No. 24594

Date 2-3-98



3004838
Page: 1 of 1
02/04/98 11:22A
LB: 5 PG: 242

FORM APPROVED BY MICHIGAN STATE BOARD OF PROFESSIONAL SURVEYORS, JAN. 28, 1971
REVISED MAY 14, 1975
REVISED JAN., 1983
REVISED OCT., 199