

SURVEY & REMONUMENTATION

FEB 13 1998

SECTION

LAND CORNER RECORDATION CERTIFICATE
Filing Requirement of Act 74, Mich. P.A. 1970

For corners in

KALKASKA Located In: Corner Code #
(County)
1997 REMONUMENTATION
1. Public Land Survey T 26N R 7W E-12
T R
T R
T R
2. Property Controlling S T R
in Section S T R
3. Miscellaneous S T R
Property in Sec. S T R

Register of Deeds Stamp & File Number

4. Lot No. , Recorded Plat

5. Private Claims

I, EUGENE FARRIER, in a field survey on OCTOBER 31, 1997
do hereby state that under requirements of P.A. 74, Michigan P.A. of 1970, the corner points
mentioned in lines 1 and 2 above were in conformance with regulations and rules therefore as
required in the current manual of survey instructions of the United States Department of the Interior,
Bureau of Land Management or by a decree of a Court of Law and /or that the corner points
mentioned in lines 3, 4 and 5 above were in conformance with the rules of the Michigan Board of
Land Surveyors or by a Decree of a Court of Law; established, re-established, monumented,
recovered, found as expressed below:

NOTE: Not more than 2 corners, all in the same town and range, may be recorded
on this certificate.

	A	B	C	D	E	F	G	H	I	J	K	L	M
1													
2	6			5		4		3		2		1	
3													
4	7			8		9		10		11		12	
5													
6	18			17		16		15		14		13	
7													
8	19			20		21		22		23		24	
9													
10	30			29		28		27		26		25	
11													
12	31			32		33		34		35		36	
13													

A. Description of original monument and accessories and/or subsequent restoration:

E-12: Cor. Common to Sec. 32 & 33, T26N-R7W Orange Twp.

1849, GLO, resurvey, set Beech post, 14" Hemlock S75W, 8, 6" Beech N40E, 23

12-26-1900, W.S. Merrill Co. Surveyor Fd. Old stake

Dec. 1971, N.L. Parker #16939, Cert. Survey, fd. 5/8" bar in Mon. box, no accessories

Dec. 1971, N.L. Parker #16939, LCR, fd. 5/8" bar in Mon. box, no accessories

09-29-1975, N.L. Parker #16939, Cert. Survey, used cor., no accessories

09-25-1975, N.L. Parker #16939, LCR, placed 1/2" x 18" bar in blacktop; approx. 2' W. Of C.L. of Hwy M-66 by evidence of M.S.H.D.;

W.S. Merrill Co. Surveyor, fence lines, sec. Corners E. & W., tag in P.P. W. 72.2' tag in 6" Ash East 80.50'


B. Description of corner evidence found and/or method applied in restoring or reestablishing corner:

E-12: Cor. Common to Sec. 32 & 33, T26N-R7W Orange Twp.

Fd. 1" iron bar in mon. box, 2.3' W. Of C.L. Hwy M-66, pulled and replaced w/ 5/8" x 18" rebar w/brass cap. No GLO witnesses were

fd. The Kalkaska Co. Peer group approved & accepted the above monument as the best available evidence of the position of the original

corner.

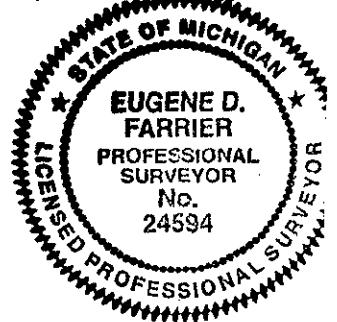

C. Description of monument for corner and accessories established to perpetuate locating the position of the corner:

E-12: Cor. Common to Sec. 32 & 33, T26N-R7W Orange Twp.

Fd. 1" iron bar in mon. box, 2.3' W. Of C.L. Hwy M-66, pulled and replaced w/ 5/8" x 18" rebar w/brass cap.

Set nail & tag N56°E 6" R. Pine 95.70'

Set nail & tag S72°E P. Pole 65.42'

Set nail & tag S80°W 12" R. Pine 59.41'

Set nail & tag N45°W 7" R. Pine 85.00'

Ratified by Peer Group
P.A. 345 - 1990 Kalkaska County

Chairman Eugene Farrier

Date 1-29-98

Signed by Eugene Farrier
Michigan License No. 24594

Date 2-3-98 Surveyor's



3004840
Page: 1 of 1
02/04/98 11:22A

FORM APPROVED BY MICHIGAN STATE BOARD OF PROFESSIONAL SURVEYORS, JAN. 28, 1971
REVISED MAY 14, 1975
REVISED JAN., 1983
REVISED OCT., 1985