

JAN 17 1996

COMMISSION

LAND CORNER RECORDATION CERTIFICATE

Filing Requirement of Act 74, Mich. P.A. 1970

KALKASKA COUNTY, MICHIGAN
RECEIVED

95 DEC 27 AM 9:54

For corners in

KALKASKA

(County)

Located In:

Corner Code #

1995 REMONUMENTATION

1. Public Land Survey T 26N R 7W F-1
2. Property Controlling S T R
- in Section S T R
3. Miscellaneous S T R
- Property in Sec. S T R

Jason Hall
REG. CLERK

Register of Deeds Stamp & File Number

4. Lot No. , Recorded Plat
5. Private Claims

I, EUGENE FARRIER, In a field survey on Oct. 19, 19 95, do hereby certify that under requirements of P.A. 74, Michigan P.A. of 1970, the corner points mentioned in lines 1 and 2 above were in conformance with regulations and rules therefore as required in the current manual of survey instructions of the United States Department of the Interior, Bureau of Land Management or by a decree of a Court of Law and/or that the corner points mentioned in lines 3, 4 and 5 above were in conformance with the rules of the Michigan Board of Land Surveyors or by a Decree of a Court of Law; established, re-established, monumented, re-monumented, recovered, found as expressed below:

NOTE: Not more than 4 corners, all in the same town and range, may be recorded on this certificate.

	A	B	C	D	E	F	G	H	I	J	K	L
2	8	5	4	3	2	1						
3												
4	7	6	5	4	3	2	1					
5												
6	18	17	16	15	14	13						
7												
8	19	20	21	22	23	24						
9												
10	30	29	28	27	26	25						
11												
12	31	32	33	34	35	36						
13												

A. Description of original monument and accessories and/or subsequent restoration:

F-1: N 1/4 Cor. of Sec. 4, T26N-R7W, Orange
1-18-1888, E.Mosher, Co.Surv, Hwy.Surv, on N-S 1/4 line, used corner.
11-4-1897, E.Beebe, Co.Surv, Hwy.Surv, ran N line, reset cor, Sgr 22", N57W, 1.5; Sgr 20", N52E, 1.14.
11-5-1975, LCRC(H.L.Fluhart), F-1, Set 5/8"x18" rerod w/cap, L.1 PG.366.
11-6-1975, H.L.Fluhart, CERT OF SURV, Set 5/8"x18" R.B. w/cap #18223. S 1/4 post, Sec. 33 T27N-R7W, East, 57.09'; TP, S62E, 72.02'; SW cor shed, N33E, 120.68.

B. Description of corner evidence found and/or method applied in restoring or reestablishing corner:

F-1: N 1/4 Cor. of Sec. 4, T26N-R7W, Orange
Fd. 5/8" x 18" R.B., 2' South of c/l of Anderson Rd. & in c/l of Krumlauf Rd. to South. Pulled & replaced with 5/8" x 18" R.B. w/brass cap 0.3' below Rd. Surface. This position not established by original government surveyors. The Kalkaska Co. peer group approved the above monument and is accepted as the best available evidence of the position of the corner.

Ratified by Peer Group
P.A. 345 - 1990 Kalkaska County

Chairman

Date


C. Description of monument for corner and accessories established to perpetuate locating the position of the corner:

F-1: N 1/4 Cor. of Sec. 4, T26N-R7W, Orange
N37E, SW corner of shed, 120.78'
N58E, SW corner of house, 169.33
East, S 1/4 corner, Sec. 33, T27N-R7W, Kal.Co.Mon., 57.10'
S02E, Rd. sign (Anderson-Krumlauf), 24.16'

Signed by

Date 12-22-95

Surveyor's Michigan License No. 24594

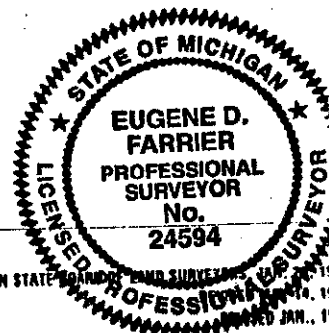

FORM APPROVED BY MICHIGAN STATE BOARD OF LAND SURVEYORS