

**SURVEY &
REMONUMENTATION**

MAR 01 2000

SECTION

**LAND CORNER RECORDATION CERTIFICATE
Filing Requirement of Act 74, Mich. P.A. 1970**

For corners in

KALKASKA

Located In:

Corner Code #

(County)

1999 REMONUMENTATION

1. Public Land Survey

T.25N R.7W

F-1

T.26N R.7W

F-13

T. R.

T. R.

2. Property Controlling
in Section

S. T. R.

S. T. R.

3. Miscellaneous
Property in Sec.

S. T. R.

S. T. R.



3020161
Page: 1 of 1
02/04/2000 03:40P
REMON
LB: 6 PG: 107

4. Lot No. , Recorded Plat

5. Private Claims

	A	B	C	D	E	F	G	H	I	J	K	L	M
1													
2		6		5		4		3		2		1	
3													
4		7		8		9		10		11		12	
5													
6		18		17		16		15		14		13	
7													
8		19		20		21		22		23		24	
9													
10		30		29		28		27		26		25	
11													
12		31		32		33		34		35		36	
13													

I, EUGENE FARRIER, in a field survey on November 4, 1999 do hereby state that under requirements of P.A. 74, Michigan P.A. of 1970, the corner points mentioned in lines 1 and 2 above were in conformance with regulations and rules therefore as required in the current manual of survey instructions of the United States Department of the Interior, Bureau of Land Management or by a decree of a Court of Law and/or that the corner points mentioned in lines 3, 4 and 5 above were in conformance with the rules of the Michigan Board of Land Surveyors or by a Decree of a Court of Law; established, re-established, monumented, recovered, found as expressed below:

NOTE: Not more than 2 corners, all in the same town and range, may be recorded on this certificate.

A. Description of original monument and accessories and/or subsequent restoration:


F-1: 1/4 Cor. Common to Sec. 4, T25N-R7W, Garfield Township; F-13: Sec. 33, T26N-R7W, Orange Township

1853, G.L.O. Resurvey, V.W. Caukin (Deputy Surveyor) Co. Survey Notes, Pg. 13, set 1/4 Sec. post, Beech 9", N2°E, 5 Lks; Beech 12", N32°W, 34 Lks
1903, Survey, by W.S. Merrill (Co. Surveyor) Co Survey Bk 25, Pgs. 2 & 3, found one B.T., Maple 14", S38°E, 28.5 Lks
1986, Survey, by E. Farrier (Co. Surveyor), set 1/4" X 39" iron pipe by fence line occupation.
1997, Survey, by Farrier Surveying, found 1/4" iron pipe cap #24594 on fence line to E, N & S, N49°E, 66.43', 10" W. Pine, N14°W, 53.34', 7" R. Pine; N54°W, 85.73', 10" R. Pine, South 9.70', 6" Cherry, fence to West is 31.5' North of corner.

B. Description of corner evidence found and/or method applied in restoring or reestablishing corner:

F-1: 1/4 Cor. Common to Sec. 4, T25N-R7W, Garfield Township; F-13: Sec. 33, T26N-R7W, Orange Township

Found 1/4" X 39" iron pipe w/ cap #24594, 31.5' S. of old fence to W., & on tree line to S. & on old fence to N. & E.
N59°W, 85.71', 12" R. Pine, set nail & washer
N19°W, 53.30', 10" R. Pine, set nail & washer
N45°E, 66.41', 16" W. Pine, set nail & washer
South, 9.67', 10" Cherry, set nail & washer
No G.L.O. witnesses were found.

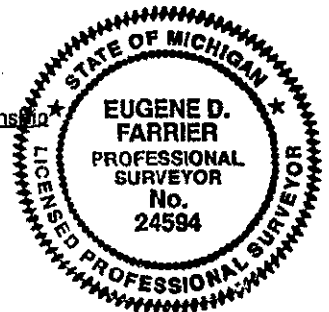

C. Description of monument for corner and accessories established to perpetuate locating the position of the corner:

F-1: 1/4 Cor. Common to Sec. 4, T25N-R7W, Garfield Township; F-13: Sec. 33, T26N-R7W, Orange Township

Found 1/4" X 39" iron pipe w/ cap #24594, 31.5' S. of old fence to W., & on tree line to S. & on old fence to N. & E. Added aluminum cap.
N59°W, 85.71', 12" R. Pine, set nail & washer
N19°W, 53.30', 10" R. Pine, set nail & washer
N45°E, 66.41', 16" W. Pine, set nail & washer
South, 9.67', 10" Cherry, set nail & washer
Kalkaska County Peer Group accepted the above monument as the best available evidence of the position of the original corner.

Ratified by Peer Group

P.A. 345-1990 Kalkaska County

Chairman Eugene Farrier

Date 02-03-00

Signed by Eugene Farrier
Surveyor's Michigan License No. 24594

Date 02-04-00