

SURVEY & MONUMENTATION

KALKASKA COUNTY, MICHIGAN
RECEIVED

JAN 17 1996

LAND CORNER RECORDATION CERTIFICATE Filing Requirement of Act 74, Mich. P.A. 1970

95 DEC 27 AM 9:55

For corners in

COMMISSION

KALKASKA

(County)

Located In:

Corner Code =#

Joan Hall
REG. DEEDS

Register of Deeds Stamp & File Number

1995 REMONUMENTATION

- | | | |
|-------------------------|------------|-----|
| 1. Public Land Survey | T 26N R 7W | H-5 |
| | T R | |
| | T R | |
| | T R | |
| | T R | |
| 2. Property Controlling | S T R | |
| in Section | S T R | |
| 3. Miscellaneous | S T R | |
| Property in Sec. | S T R | |

4. Lot No. _____, Recorded Plat _____
5. Private Claims _____

I, EUGENE FARRIER, in a field survey on Oct. 23, 19 95, do hereby certify that under requirements of P.A. 74, Michigan P.A. of 1970, the corner points mentioned in lines 1 and 2 above were in conformance with regulations and rules therefore as required in the current manual of survey instructions of the United States Department of the Interior, Bureau of Land Management or by a decree of a Court of Law and/or that the corner points mentioned in lines 3, 4 and 5 above were in conformance with the rules of the Michigan Board of Land Surveyors or by a Decree of a Court of Law; established, re-established, monumented, re-monumented, recovered, found as expressed below:

NOTE: Not more than 4 corners, all in the same town and range, may be recorded on this certificate.

	A	B	C	D	E	F	G	H	I	J	K	L
2	8	5						3		2		1
3												
4	7	6						10		11		12
5												
6	18	17						15		14		13
7												
8	19	20						22		23		24
9												
10	30	29						27		26		25
11												
12	31	32						34		35		36
13												

A. Description of original monument and accessories and/or subsequent restoration:

H-5: Cor. common to Sec. 10 & 15, T26N-R7W, Orange
1850 GLO re-survey: S 1/4 corner, Sugar 11".
6-6-1876, D.E.McVee, Co.Surv, HwySurv, surveyed S.line, used crnr.
9-8-1911, W.S.Merrill, Co.Surv, Set iron w/glass, no wits.
9-27-1935, Kalkaska Cnty. Rd. Commission, Set iron pipe.
8-27-1983, E.D.Farrier, CERT OF SURV, fd. 1/2" iron w/cap #13030, L.2 PG.792.
1-7-1987, LCRC(E.D.Farrier), H-5, fd. 1/2" iron w/cap #13030, L.3 PG.302.

B. Description of corner evidence found and/or method applied in restoring or reestablishing corner:

H-5: Cor. common to Sec. 10 & 15, T26N-R7W, Orange
Fd 1/2" R.B. w/cap #13030, 2' South of c/l of Cool Rd. Pulled & replaced with 5/8" x 18" R.B. w/brass cap 0.3' below Rd. Surface. No GLO wit. were fd. The Kalkaska Co. peer group approved the above monument and is accepted as the best available evidence of the position of the original corner.

Ratified by Peer Group
P.A. 345 - 1990 Kalkaska County

Chairman *Eugene Farrier*

Date 12-19-95


C. Description of monument for corner and accessories established to perpetuate locating the position of the corner:

H-5: Cor. common to Sec. 10 & 15, T26N-R7W, Orange
Fd 1/2" R.B. w/cap #13030. Pulled & replaced with 5/8" x 18" R.B. w/brass cap 0.3' below Rd. Surface.
Set nail & tag N30W, P.P., 42.33'
Set nail & tag N05W, 8" Maple, 57.05'
Set nail & tag S27E, 6" Maple, 35.83'
Set nail & tag S05W, 12" Maple, 32.25'

Signed by *Eugene Farrier*

Date 12-22-95

Surveyor's Michigan License No. 24594

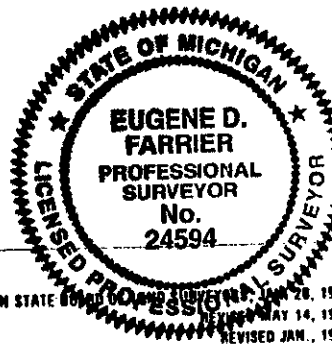

FORM APPROVED BY MICHIGAN STATE BOARD OF SURVEYORS MAY 14, 1995
REVISED JAN. 19