

SURVEY &  
REMONUMENTATION

MAR 21 1997

KALKASKA COUNTY, MICHIGAN  
RECEIVED

COMMISSION LAND CORNER RECORDATION CERTIFICATE  
Filing Requirement of Act 74, Mich. P.A. 1970

97 JAN 31 PM 2:26

For corners in

KALKASKA

(County)

Located In:

Corner Code #1

1996 REMONUMENTATION

1. Public Land Survey

T 26N R 6W

T 26N R 7W

T R

T R

T R

2. Property Controlling  
in Section

S T R

S T R

3. Miscellaneous

S T R

Property in Sec.

S T R

*Joan Hall*  
REG. CLERK

Register of Deeds Stamp & File Number

1. Lot No. , Recorded Plat

2. Private Claims

EUGENE FARRIER

Nov. 14

19 96

to hereby certify that under requirements of P.A. 74, Michigan P.A. of 1970, the corner points mentioned in lines 1 and 2 above were in conformance with regulations and rules therefore as required in the current manual of survey instructions of the United States Department of the Interior, Bureau of Land Management or by a decree of a Court of Law and/or that the corner points mentioned in lines 3, 4 and 5 above were in conformance with the rules of the Michigan Board of Land Surveyors or by a Decree of a Court of Law; established, re-established, monumented, re-monumented, recovered, found as expressed below:

NOTE: Not more than 4 corners, all in the same town and range, may be recorded on this certificate.

Description of original monument and accessories and/or subsequent restoration:

A-02: Cor. common to Sec. 1, T26N-R7W, Orange Township, & Sec. 6, T26N-R6W, Oliver Township

04-07-1839, GLO original survey, J.H.Mullett, set post. 6" Lynn N11W 20, 8" Sugar S50W 22.

July 23, 1904, W.S.Merrill, fd old stake Cedar stake old iron buried, no accessories.

11-10-1972, C.F.Roser, fd. old irs. per. Merrill Survey in 1904, added D.N.R mon.

11-10-1972, LCRC Liber 1 pg. 177.

Description of corner evidence found and/or method applied in restoring or reestablishing corner:

A-02: Cor. common to Sec. 1, T26N-R7W, Orange Township, & Sec. 6, T26N-R6W, Oliver Township

Found DNR Mon w/ 4"x4" Cedar Post w/ accessories. Left in place. No GLO witnesses found. The Kalkaska Co. peer group approved & accepted the above monument as a careful and faithful perpetuation of the position of the original corner.

Ratified by Peer Group

P.A. 345 - 1990 Kalkaska County

Chairman

Date

Description of monument for corner and accessories established to perpetuate locating the position of the corner:

A-02: Cor. common to Sec. 1, T26N-R7W, Orange Township, & Sec. 6, T26N-R6W, Oliver Township

Found DNR Mon w/ 4"x4" Cedar Post w/ accessories. Left DNR Monument in place.

Set nail N24E 12" Tw. Cherry, 53.24' (old)

Set nail S60E 6" Ironwood, 13.10' (old)

Set nail S19E 8" Maple, 18.73' (old)

Set nail West 4"x4" Cedar Post, 1.15' (old)


igned by

urveyor's Michigan License No.

Date

1-30-97

24594

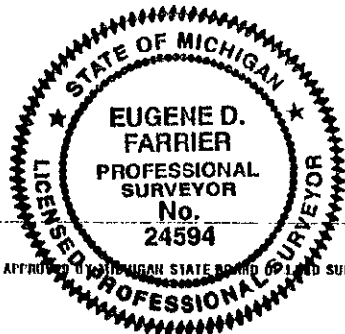

FORM APPROVED BY MICHIGAN STATE BOARD OF LAND SURVEYORS, JAN. 28, 1971  
REVISED MAY 14, 1975  
REVISED JAN., 1983