

FEB 18 1994

COMMISSION

LAND CORNER RECORDATION CERTIFICATE

Filing Requirement of Act 74, Mich. P.A. 1970

KALKASKA COUNTY, MICHIGAN  
RECEIVED

for corners in

KALKASKA

(County)

1993 REMONUMENTATION

Located In:

Corner Code #

1993 DEC 22 PM 1:29

Public Land Survey

T 27N R 7W

D-7

Property Controlling

S T R

in Section

S T R

Miscellaneous

S T R

Property in Sec.

S T R

*Joan Hall*  
REG OF DEEDS

Register of Deeds Stamp & File Number

Lot No. , Recorded Plat

Private Claims

EUGENE FARRIER, in a field survey on NOV. 23, 19 93

whereby certify that under requirements of P.A. 74, Michigan P.A. of 1970, the corner points mentioned in lines 1 and 2 above were in conformance with regulations and rules therefore as required in the current manual of survey instructions of the United States Department of the Interior, Bureau of Land Management or by a decree of a Court of Law and/or that the corner points mentioned in lines 3, 4 and 5 above were in conformance with the rules of the Michigan Board of Land Surveyors or by a Decree of a Court of Law; established, re-established, monumented, re-monumented, recovered, found as expressed below:

NOTE: Not more than 4 corners, all in the same town and range, may be recorded on this certificate.

Description of original monument and accessories and/or subsequent restoration:


D-7 cor. common to Sec. 17 & 20, T27N-R7W  
1850 GLO re-survey; set post, W. Pine 16", S51E, 42; Y. Pine 14", N74W, 194  
6-1886, E. Mosher, Co. Surv., tied cor., Beech 10", N88W, 47, Hem. 18", S20E, 28.  
10-26-08, W.S. Merrill, Co. Surv., set iron stake.  
MSDH, plans for U.S. 131, tied to corner  
5-52, A.L. Dragoo, Co. Surv., R.R. Rail, Co. Surv. records.  
10-12-72, J.L. Wilcox, fd 3/4" pipe, Liber 1 Pg 242 of Surv.  
10-12-72, LCRC Liber 1 Pg 148.  
9-73, J.L. Fletcher, fd w/accessories, Liber 1 Pg 428 of Surv.  
10-24-73, LCRC Liber 1 Pg 268.  
10-73, J.L. Fletcher, fd w/accessories, Liber 1 Pg 432 of Surv.  
1-8-74, J.L. Fletcher, fd w/accessories, Liber 1 Pg 477 of Surv.  
2-1-74, D.R. Verba, fd 1/2" pipe w/accessories, Liber 1 Pg 473-475 of Surv.  
7-16-74, J.L. Fletcher, fd w/accessories, Liber 1 Pg 601 of Surv.  
11-4-74, J.L. Fletcher, fd w/accessories, Liber 1 Pg 611 of Surv.  
1-9-75, J.L. Fletcher, fd w/accessories, Liber 1 Pg 643 of Surv.  
11-10-77, J.L. Fletcher, fd w/accessories, Liber 2 Pg 126 of Surv.  
12-6-77, J.L. Fletcher, fd w/accessories, Liber 2 Pg 147 of Surv.  
6-26-79, J.L. Fletcher, fd w/accessories, Liber 2 Pg 362 of Surv.  
2-17-89, E. Farrier, fd 3/4" Pipe & accessories, Liber 3 Pg 292 of Surv.  
3-2-89, LCRC Liber 2 Pg 372.  
5-12-89, E. Farrier, fd w/accessories, Liber 3 Pg 482 of Surv.

Description of corner evidence found and/or method applied in restoring or reestablishing corner:

D-7 cor. common to Sec. 17 & 20, T27N-R7W  
Found 3/4" iron pipe & accessories, accepted, GLO witnesses fall in road cut area and other cleared areas.  
On 12-16-93 the Kalkaska Co. peer group approved the above monument as a careful and faithful reestablishment of the position of the original corner.

Description of monument for corner and accessories established to perpetuate locating the position of the corner:

D-7 cor. common to Sec. 17 & 20, T27N-R7W  
Found 3/4" iron pipe - Pulled pipe and reset w/ 5/8" re-rod w/ Brass Cap  
N40W, 66.30', Light Pole (fd spk w/tag)  
N50E, 28.36', Light Pole (fd spk w/tag)  
S60E, 134.35', Light Pole (set spk)  
S05W, 75.18', 1/2" re-rod w/cap #19830  
C/L Island Lake Road is SWly, 28.0'  
C/L Alley is NWly, 42.0'

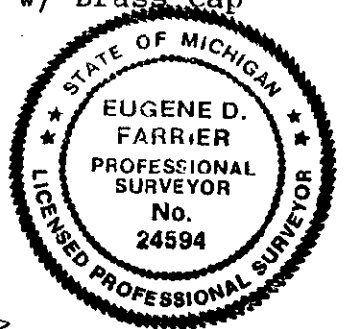

igned by *Eugene Farrier*

Date 12-22-93

veyor's Michigan License No. 24594