

FEB 18 1994

COMMISSION

LAND CORNER RECORDATION CERTIFICATE  
Filing Requirement of Act 74, Mich. P.A. 1970

For corners in

KALKASKA

Located In:

Corner Code =#

(County)  
1993 REMONUMENTATION

KALKASKA COUNTY, MICHIGAN  
RECEIVED

1993 DEC 22 PM 1:30

*Joan Hall*  
REG. OF DEEDS

1. Public Land Survey

T 27N R 7W

D-11

2. Property Controlling  
in Section

S T R

3. Miscellaneous

S T R

Register of Deeds Stamp & File Number

4. Lot No. \_\_\_\_\_, Recorded Plat \_\_\_\_\_

5. Private Claims \_\_\_\_\_

I, EUGENE FARRIER, in a field survey on NOV. 23, 19 93,  
do hereby certify that under requirements of P.A. 74, Michigan P.A. of 1970, the corner points mentioned  
in lines 1 and 2 above were in conformance with regulations and rules therefore as required in the  
current manual of survey instructions of the United States Department of the Interior, Bureau of Land  
Management or by a decree of a Court of Law and/or that the corner points mentioned in lines 3, 4 and 5  
above were in conformance with the rules of the Michigan Board of Land Surveyors or by a Decree of a  
Court of Law; established, re-established, monumented, re-monumented, recovered, found as  
expressed below:

**NOTE: Not more than 4 corners, all in the same town and range, may be recorded  
on this certificate.**

A. Description of original monument and accessories and/or subsequent restoration:

D-11 cor. common to Sec. 29 & 32, T27N-R7W

1850 GLO re-survey: set post, Y. Birch 6", S32E, 29; Beech 6", N55W, 30.

12-1-05, W.S. Merrill, Co. Surv. Cedar stake and Pine 30", N17W, 38.

M.S.H.D. M.A. Koivisto, fd 1 1/4" pipe, pg 58 of Survey book #1.

8-14-71, LCRC Liber 1 Pg 40.

11-7-74, LCRC Liber 1 Pg 343.

12-27-71, J.F. Erickson, fd 1/2" pipe, Liber 1 Pg 50 of Surv.

6-26-75, J.L. Fletcher, fd iron pipe, Liber 1 Pg 828-289 of Surv.

10-6-75, J.I. Nelson, fd 1/2" iron pipe, Liber 1 Pg 781-782 of Surv.

6-1-79, J.L. Fletcher, fd 1/2" iron pipe, Liber 2 Pg 346.

11-24-80, J.I. Nelson, fd 1/2" iron pipe w/ 1/4" re-rod inside, Liber 2 Pg 616-618.

B. Description of corner evidence found and/or method applied in restoring or reestablishing corner:

D-11 cor. common to Sec. 29 & 32, T27N-R7W

Found 3/4" iron pipe w/ 3/8" re-rod in cen. in C/L Motz road, 2' W. of C/L  
trail South and in line w/ fnc North. Removed iron pipe & re-rod (badly  
bent) found 1" iron pipe 2.2' below surface 0.23' NNE. GLO & old Co.  
Surv. witnesses fall in road fill area.

On 12-16-93 the Kalkaska Co. peer group approved the above monument as a  
careful and faithful reestablishment of the position of the original  
corner.

C. Description of monument for corner and accessories established to perpetuate locating the position of the corner:

D-11 cor. common to Sec. 29 & 32, T27N-R7W


Found 3/4" iron pipe w/ 3/8" re-rod in cen. Removed iron pipe & re-rod,  
drove 5/8"x36" re-rod w/ Brass Cap in cen. of 1" pipe set Mon. box

N58E, 100.41', 20" W. Pine.

S62E, 92.93', 32" W. Pine.

S13W, 48.64', 16" W. Birch.

N5E, 32.78', Iron & Cap.

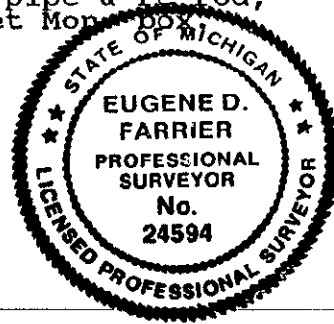

Signed by

Date 12-22-93

Surveyor's Michigan License No.

24594