

# SURVEY & REMONUMENTATION

JAN 17 1996

## LAND CORNER RECORDATION CERTIFICATE Filing Requirement of Act 74, Mich. P.A. 1970

For corners in

COMMISSION

KALKASKA  
(County)

Located In:

Corner Code -#

1995 REMONUMENTATION

1. Public Land Survey

T 27N R 7W

L-13

T R

T R

T R

2. Property Controlling  
in Section

S T R

S T R

3. Miscellaneous  
Property in Sec.

S T R

S T R

4. Lot No. , Recorded Plat

5. Private Claims

KALKASKA COUNTY, MICHIGAN  
RECEIVED

95 DEC 27 AM 9:54

*Joan Hall*  
REG. DEEDS

Register of Deeds Stamp & File Number

I, EUGENE FARRIER, in a field survey on Dec. 5, 19 95, do hereby certify that under requirements of P.A. 74, Michigan P.A. of 1970, the corner points mentioned in lines 1 and 2 above were in conformance with regulations and rules therefore as required in the current manual of survey instructions of the United States Department of the Interior, Bureau of Land Management or by a decree of a Court of Law and/or that the corner points mentioned in lines 3, 4 and 5 above were in conformance with the rules of the Michigan Board of Land Surveyors or by a Decree of a Court of Law; established, re-established, monumented, re-monumented, recovered, found as expressed below:

**NOTE:** Not more than 4 corners, all in the same town and range, may be recorded on this certificate.

A. Description of original monument and accessories and/or subsequent restoration:

L-13: S 1/4 Corner, Sec. 36, T27N-R7W, Kalkaska  
1850, GLO resurvey, set post, Y. Birch 5", N50W, 18; Cdr 6", S55E, 29.  
10-30-1973, Granger, CERT OF SURV, L.1 PG.634, Computed position single  
PRO between SE & SW corners of Sec. 36, T27N-R7W.

B. Description of corner evidence found and/or method applied in restoring or reestablishing corner:

L-13: S 1/4 Corner, Sec. 36, T27N-R7W, Kalkaska  
Set 5/8" x 18" R.B. w/aluminum cap. Set midway on online between SW & SE corners of Sec. 36, T27N-R7W. The Kalkaska Co. peer group approved the above monument as a careful and faithful reestablishment of the position of the original corner.

Ratified by Peer Group  
P.A. 345 - 1990 Kalkaska County

Chairman *Eugene Farrier*

Date 12-19-95


C. Description of monument for corner and accessories established to perpetuate locating the position of the corner:

L-13: S 1/4 Corner, Sec. 36, T27N-R7W, Kalkaska  
Set 5/8" x 18" R.B. w/aluminum cap.  
Set nail & tag N28W, 12" Maple, 11.88'  
Set nail & tag N11W, 13" Cedar, 28.40'  
Set nail & tag N08E, 7" Cedar, 14.04'  
West, N 1/4 Cor., Sec. 1, T26N-R7W, Kal.Co.Mon, 13.86'

Signed by *Eugene Farrier*

Date 12-22-95

Surveyor's Michigan License No. 24594

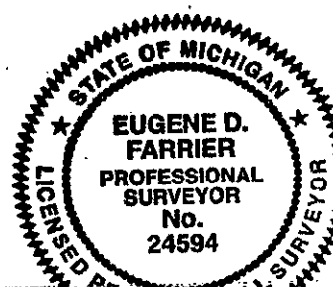

FORM APPROVED BY MICHIGAN STATE BOARD OF LAND SURVEYORS, JAN. 28, 19  
REVISED MAY 14, 19  
REVISED JAN. 19