

REMONUMENTATION  
\$7.00  
\$2.00 SEP 18 1995

LAND CORNER RECORDATION CERTIFICATE  
Filing Requirement of Act 74, Mich. P.A. 1970  
KENT COUNTY REMONUMENTATION

For corners in

Kent  
(County)

Located in:

Corner Code #

1. Public Land Survey

T 5N R 12W E-9

T \_\_\_\_\_ R \_\_\_\_\_

T \_\_\_\_\_ R \_\_\_\_\_

T \_\_\_\_\_ R \_\_\_\_\_

2. Property Controlling  
in Section

S \_\_\_\_\_ T \_\_\_\_\_ R \_\_\_\_\_

S \_\_\_\_\_ T \_\_\_\_\_ R \_\_\_\_\_

3. Miscellaneous  
Property in Sec.

S \_\_\_\_\_ T \_\_\_\_\_ R \_\_\_\_\_

S \_\_\_\_\_ T \_\_\_\_\_ R \_\_\_\_\_

4. Lot No. \_\_\_\_\_, Recorded Plat \_\_\_\_\_


5. Private Claims \_\_\_\_\_

I, Randy Kolehouse, in a field survey on April 13 19 95,  
do hereby certify that under requirements of P.A. 74 Michigan P.A. of 1970, the corner points  
mentioned in lines 1 and 2 above were in conformance with regulations and rules therefore as required  
in the current manual of survey instructions of the United States Department of the Interior, Bureau of  
Land Management or by a decree of a Court of Law and/or that the corner points mentioned in lines 3,  
4 and 5 above were in conformance with the rules of the Michigan Board of Land Surveyors or by a  
Decree of a Court of Law; established, re-established, monumented, re-monumented, recovered,  
found as expressed below:

NOTE: Not more than 4 corners, all in the same town and range, may be recorded  
on this certificate.

A. Description of original monument and accessories and/or subsequent restoration:

F-9	1831	G.L.O. Notes	Mullett	Set Post
	1963	Wit. Map	K.C. Surveyor	Bt. Spike
	1974	L.C.R.C. #703	Exxel Engineering	Found Bt. Spike
	1981	L.C.R.C. #1643	Nederveld & Jonker	Found Bt. Spike/Set K.C. Monument
	1988	L.C.R.C. #4618	Olson, Meyers & May	K.C. Monument

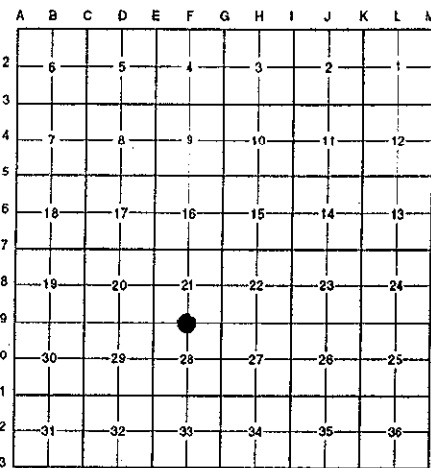

P.A. 345 1990 KENT COUNTY

PEER APPROVED 5/25/95

CHAIRMAN Randy Kolehouse

This corner was originally approved by the Kent County Remonumentation Peer Group and monumented by Nederveld & Jonker on 2/12/81 and was recorded per L.C.R.C. #1643.

B. Description of corner evidence found and/or method applied in restoring or reestablishing corner:

F-9 Found standard Kent County Monument 4.0' South of C/L of 92nd Street running E-W and on fence line running South per L.C.R.C.'s #1643 and #4618 as set by Nederveld & Jonker in place of a bt. spike they found which checked L.C.R.C. #703 and K.C. Surveyor Wit. Map.

L.C.R.C. #1643

L.C.R.C. #4618

SW corner porch NE (base of brick) 138.38' - N50° E

SW cor porch (base of brick) N 50° E 138.38'

NW cor. hse ESE 179.45' - S70°E

NW cor hse conc fndn S 70° E 179.45'

Nail & Remon. tag on W side P. pole S 40.15' - S5°E

Nail & Remon tag on W sde P pole S 5° E 40.15'

The selected location is accepted by me and is generally accepted by professional surveyors as the best available evidence of the position of the original corner.

C. Description of monument for corner and accessories established to perpetuate locating the position of the corner:

F-9 Standard Kent County Monument


SW cor. porch (base of brick) N 50° E 138.38'

NW cor. hse. S 70° E 179.45'

Nail & K.C. remon. tag on W side P. pole S 5° E 40.15'

Nail & K.C. remon. tag on W side P. pole S 5° E 40.15'

Chiseled "X" in North end conc. culvert due North 20.07'

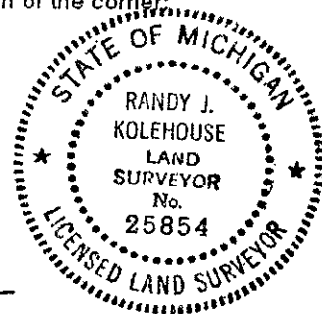

Signed by Randy J. Kolehouse

Date 8/21/95

EARTH TECH

Surveyor's Michigan License No. 25854