

\$7.00
\$2.00

SEP 18 1995

COMMISSION

LAND CORNER RECORDATION CERTIFICATE
Filing Requirement of Act 74, Mich. P.A. 1970
KENT COUNTY REMONUMENTATION

For corners in

Kent
(County)

Located in:

Corner Code #

- | | | |
|------------------------------------|--------------------------|------------|
| 1. Public Land Survey | T <u>5N</u> R <u>12W</u> | <u>I-7</u> |
| | T _____ R _____ | _____ |
| | T _____ R _____ | _____ |
| | T _____ R _____ | _____ |
| 2. Property Controlling in Section | S _____ T _____ R _____ | _____ |
| | S _____ T _____ R _____ | _____ |
| 3. Miscellaneous Property in Sec. | S _____ T _____ R _____ | _____ |
| | S _____ T _____ R _____ | _____ |

REG. OF DEEDS

Handwritten signature

95 AUG 28 AM 10:52

STATE OF MICHIGAN
COUNTY OF KENT
RECEIVED FOR RECORD

8630

Register of Deeds Stamp & File Number


4. Lot No. _____, Recorded Plat _____
5. Private Claims _____

I, Randy Kolehouse, in a field survey on April 6 19 95, do hereby certify that under requirements of P.A. 74 Michigan P.A. of 1970, the corner points mentioned in lines 1 and 2 above were in conformance with regulations and rules therefore as required in the current manual of survey instructions of the United States Department of the Interior, Bureau of Land Management or by a decree of a Court of Law and/or that the corner points mentioned in lines 3, 4 and 5 above were in conformance with the rules of the Michigan Board of Land Surveyors or by a Decree of a Court of Law; established, re-established, monumented, re-monumented, recovered, found as expressed below:

NOTE: Not more than 4 corners, all in the same town and range, may be recorded on this certificate.

A. Description of original monument and accessories and/or subsequent restoration:

I-7	1831	G.L.O. Notes	Mullett	Set Post
	1937	Wit. Map	K.C. Surveyor	Pipe
	1972	L.C.R.C. #333	Williams & Works	Found 1" Iron in Mon. Box
	1977	L.C.R.C. #1041	Exxel Engineering	Found 1" Iron in Mon. Box
	1991	L.C.R.C. #6331	Chris Marschall	Found 1" Iron in Mon. Box/Set K.C. Monument

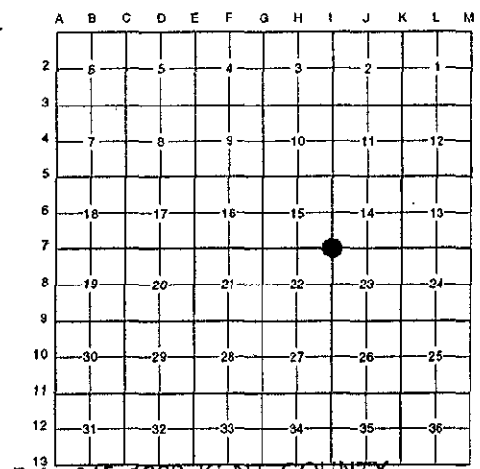

P.A. 345 1930 KENT COUNTY

PEER APPROVED 8/24/95

CHAIRMAN *Handwritten signature*

This corner was originally approved by the Kent County Remonumentation Peer Group and monumented by Chris Marschall on 12/18/91 and was recorded per L.C.R.C. #6331.

B. Description of corner evidence found and/or method applied in restoring or reestablishing corner:

I-7 Found standard Kent County Monument in a monument box at the C/L intersection of 84th Street running E-W and Burlingame Avenue running N-S per L.C.R.C.'s #333, #1041 and #6331.

L.C.R.C. #338	L.C.R.C. #1041	L.C.R.C. #6331
CP pole S47°W 81.0'	PK in sde Lt. Pole NE 52.35'	Nail & Tag in N. side P.P. S 45 E 118.65'
	PK in sde P. Pole SW 80.88'	Nail & Tag in NW side P.P. N 54 E 52.29'
		Nail & Tag SW sde 14" Elm Stump N 75 E 150.78'
		Nail & Tag N sde P.P. 5' above grd. S 42 W 80.89'

The selected location is accepted by me and is generally accepted by professional surveyors as the best available evidence of the position of the original corner.

C. Description of monument for corner and accessories established to perpetuate locating the position of the corner:

I-7 Standard Kent County Monument in a Monument Box

- Nail & K.C. remon. tag in N. side P. pole S 45° E 118.65'
- Nail & K.C. remon. tag in NW side P. pole N 54° E 52.29'
- Nail & K.C. remon. tag in SW side 14" Elm Stump N 75° E 150.78'
- Nail & K.C. remon. tag in N side P. pole 5' above ground S 42° W 80.89'

Signed by *Handwritten signature of Randy Kolehouse*
EARTH TECH

Date 8/21/95

Surveyor's Michigan License No. 25854

