

SEP 18 1995

COMMISSION

LAND CORNER RECORDATION CERTIFICATE
Filing Requirement of Act 74, Mich. P.A. 1970
KENT COUNTY REMONUMENTATION

For corners in

Kent
(County)

Located in:

Corner Code #

1. Public Land Survey

T 5N R 12W

K-11

2. Property Controlling
in Section

S

T

R

3. Miscellaneous
Property in Sec.

S

T

R

4. Lot No. , Recorded Plat

5. Private Claims

REC. OF DEEDS

95 AUG 28 AM 10:54

STATE OF MICHIGAN
COUNTY OF KENT
RECEIVED FOR RECORD

8654

Register of Deeds Stamp & File Number

I, Randy Kolehhouse, in a field survey on April 5 19 95, do hereby certify that under requirements of P.A. 74 Michigan P.A. of 1970, the corner points mentioned in lines 1 and 2 above were in conformance with regulations and rules therefore as required in the current manual of survey instructions of the United States Department of the interior, Bureau of Land Management or by a decree of a Court of Law and/or that the corner points mentioned in lines 3, 4 and 5 above were in conformance with the rules of the Michigan Board of Land Surveyors or by a Decree of a Court of Law; established, re-established, monumented, re-monumented, recovered, found as expressed below:

NOTE: Not more than 4 corners, all in the same town and range, may be recorded on this certificate.

A. Description of original monument and accessories and/or subsequent restoration:

K-11	1831	G.L.O. Notes	Mullett	Set Post
	1936	Wit. Map	K.C. Surveyor	Iron & Leaded Stone
	1971	L.C.R.C. #36	Williams & Works	Found 3/4" Iron in Mon. Box
	1972	L.C.R.C. #749	Don Ratekin	Iron Pipe
	1980	L.C.R.C. #1497	Williams & Works	Found 3/4" Iron in Mon. Box/Set K.C. Monument
	1991	L.C.R.C. #6353	Chris Marshall	K.C. Monument

P.A. 345 1990 KENT COUNTY

PEER APPROVED 6/27/95
CHAIRMAN Harry Thibault

This corner was originally approved by the Kent County Remonumentation Peer Group and monumented by Williams & Works on 12/9/80 and was recorded per L.C.R.C. #1499.

B. Description of corner evidence found and/or method applied in restoring or reestablishing corner:

K-11 Found standard Kent County Monument at the C/L intersection of Clyde Park Avenue running N-S and 100th Street running E-W per L.C.R.C.'s #1499 and #6353 as set by Williams & Works in place of 3/4" iron in monument box the found which checked L.C.R.C.'s #36 and #749 and K.C.R.C. Wit. 1936.

L.C.R.C. #1499

L.C.R.C. #6353


Nail & K.C. Remon. Tag in East Side 48" Maple S 20°W 73.21'	Nail & Tag SW sde. U.P. S 52 E 49.60'
	Nail & Tag W sde. 38" Maple S 22 W 73.77'
	Nail & Tag S sde. U.P. S 83 W 222.05'
	Top center 6" x 6" MBT Box N 28 E 66.03'
	Nail & Tag E sde. 10" Maple S 48 W 71.85'

The selected location is accepted by me and is generally accepted by professional surveyors as the best available evidence of the position of the original corner.

C. Description of monument for corner and accessories established to perpetuate locating the position of the corner:

K-11 Standard Kent County Monument

Nail & K.C. remon. tag on SW side Utl. pole 2°E 49.60'
Nail & K.C. remon. tag on W side 38" Maple S 22° W 73.77'
Nail & K.C. remon. tag on S side Utl. pole S 83° W 222.05'
Top center 6" x 6" MBT Box N 28° E 66.03'
Nail & K.C. remon. tag on E side 10" Maple S 48° W 71.85'

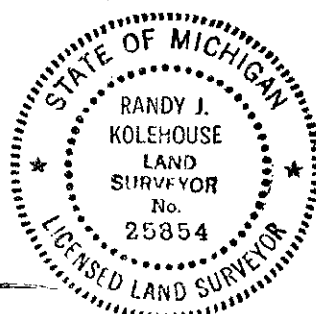

Signed by Randy J. Kolehhouse

Date 8/2/95

Surveyor's Michigan License No. 25854