

\$7.00  
\$2.00

SEP 13 1993

CONFIRMATION

LAND CORNER RECORDATION CERTIFICATE  
Filing Requirement of Act 74, Mich. P.A. 1970  
KENT COUNTY REMONUMENTATION

For corners in

Kent  
(County)

Located in:

Corner Code #

1. Public Land Survey

T 5N R 12W

M-9

T R

T R

T R

T R

2. Property Controlling  
in Section

S T R

S T R

3. Miscellaneous

S T R

Property in Sec.

S T R

4. Lot No. , Recorded Plat

5. Private Claims

REG. OF DEEDS

95 AUG 28 AM 10:55

STATE OF MICHIGAN  
COUNTY OF KENT  
RECEIVED FOR RECORD

8672

Register of Deeds Stamp & File Number

I, Randy Kolehouse, in a field survey on March 15 19 95, do hereby certify that under requirements of P.A. 74 Michigan P.A. of 1970, the corner points mentioned in lines 1 and 2 above were in conformance with regulations and rules therefore as required in the current manual of survey instructions of the United States Department of the interior, Bureau of Land Management or by a decree of a Court of Law and/or that the corner points mentioned in lines 3, 4 and 5 above were in conformance with the rules of the Michigan Board of Land Surveyors or by a Decree of a Court of Law; established, re-established, monumented, re-monumented, recovered, found as expressed below:

NOTE: Not more than 4 corners, all in the same town and range, may be recorded on this certificate.

A. Description of original monument and accessories and/or subsequent restoration:

M-9	1817	G.L.O. Notes	L. Lyon	Set Post
	1937-1960	Wit. Map	K.C. Surveyor	1/2" Iron & Stone
	1905-1971	Survey Notes	Williams & Works	Iron & Stone
	1983	L.C.R.C. #3582	W. Byle	Found 1" Iron Pipe Over 1/2" Iron Pipe/Set K.C. Monument
	1991	L.C.R.C. #6369	Chris Marschall	K.C. Monument

P.A. 345 1990 KENT COUNTY

PEER APPROVED 6/27/99

CHAIRMAN Harry Stutts

This corner was originally approved by the Kent County Remonumentation Peer Group and monumented by William Byle on 9/27/83 and was recorded per L.C.R.C. #3582.

B. Description of corner evidence found and/or method applied in restoring or reestablishing corner:

M-9 Found standard Kent County Monument in the C/L of 92nd Street running E-W per L.C.R.C.'s #3582 and #6369 as set by William Byle in place of 1" iron pipe over a 1/2" iron pipe he found which checked witness from Williams & Works 1941 survey and meas. with MDSH R/W data for US-131. This point is on the Town line and is 10.60' North of the SW cor., Sec. 19, T5N R11W (Kent Co. Mon.)

L.C.R.C. #3582

L.C.R.C. #6369

Nail & tag, N sd. 16" Maple N 55 W 48.26'  
Nail & tag, W sd. 24" Maple N 05 W 59.30'  
Nail & tag, S sd. 6" Maple S 55 E 48.44'  
SW cor. Sec. 19, 5-11 (Kent County Monument) S 00 W 10.60'


Nail & Tag N sd 18" Maple N 55 W 48.53'  
Nail & Tag W sd 26" Maple N 05 W 59.32'  
Nail & Tag S sd 8" Maple S 55 E 48.40'  
SW Cor. Sec. 19 5-11 S 00 W 10.60'

The selected location is accepted by me and is generally accepted by professional surveyors as the best available evidence of the position of the original corner.

C. Description of monument for corner and accessories established to perpetuate locating the position of the corner:

M-9 Standard Kent County Monument

Nail & K.C. remon. tag on N side 18" Maple N 55° W 48.53'  
Nail & K.C. remon. tag on W side 26" Maple N 05° W 59.36'  
Nail & K.C. remon. tag on S side 8" Maple S 55° E 48.40'  
Nail & K.C. remon. tag on SE side Util. pole N 45° E 37.22'  
K.C.R.C. A-9 T5N R11W S 04° W 10.69'

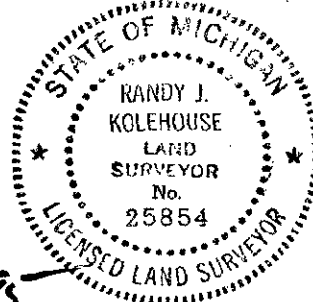

Signed by Randy J. Kolehouse Date 8/21/95

EARTH TECH

Surveyor's Michigan License No. 25854