

SURVEY & REMONUMENTATION

MAR 08 1999

LAND CORNER RECORDATION CERTIFICATE  
Filing Requirement of Act 74, Mich. P.A. 1970  
KENT COUNTY REMONUMENTATION

38 DEC 14 AM 8:00

STATE OF MICHIGAN  
COUNTY OF KENT  
RECEIVED FOR RECORD

REG. OF DEEDS

other code # 4

11029

Register of Deeds Stamp & File Number

For corners in

Kent  
(County)

SECTION

Located in: Vergennes  
Township

Corner Code #

1. Public Land Survey

T 7N R 9W J-9W

T R

T R Witness Corner

T R

2. Property Controlling  
in Section

S T R

S T R

3. Miscellaneous  
Property in Sec.

S T R

S T R

4. Lot No. , Recorded Plat

5. Private Claims

I, Randy Kolehouse, in a field survey on January 23 19 98, do hereby certify that under requirements of P.A. 74 Michigan P.A. of 1970, the corner points mentioned in lines 1 and 2 above were in conformance with regulations and rules therefore as required in the current manual of survey instructions of the United States Department of the interior, Bureau of Land Management or by a decree of a Court of Law and/or that the corner points mentioned in lines 3, 4 and 5 above were in conformance with the rules of the Michigan Board of Land Surveyors or by a Decree of a Court of Law; established, re-established, monumented, re-monumented, recovered, found as expressed below:

NOTE: Not more than 4 corners, all in the same town and range, may be recorded on this certificate.

A. Description of original monument and accessories and/or subsequent restoration:

J-9	1838	G.L.O. Notes	N. Brookfield	Point in River
	1989	L.C.R.C. #5221	John Bueche	Set K.C. Witness Monumen
	1995	L.C.R.C. #8247	William Byl	K.C. Witness Monument

P.A. 345 1990 KENT COUNTY

PEER APPROVED 2/19/98

CHAIRMAN Henry J. Bueche

This corner was originally approved by the Kent County Remonumentation Peer Group and monumented by John Bueche on 1/9/98 and was recorded per L.C.R.C. #5221.

B. Description of corner evidence found and/or method applied in restoring or reestablishing corner:

J-9 Found a Standard Kent County Witness Monument 21.0' North of the Flat River 559.64' West of J-9 per L.C.R.C.'s #5221 and #8247 as set by John Bueche on the South line of Sections 23.

L.C.R.C. #5221

L.C.R.C. #8247

Nail & Remon tag N side 22" Oak N 60° W 11.70  
Nail & Remon tag S side 12" Poplar S 90° W 16.25'  
Nail & Remon tag E side dbl 10" Ash N 30° W 2.76'  
Nail & Remon tag N side 10" Nut tree N 40° E 6.79'  
Nail & Remon tag N side 8" Elm S 70° E 16.90'


Nail & KC Remon. tag N. side 24" Oak N 60° W 11.55'  
Nail & KC Remon. tag S. side 12" Poplar S 90° E 16.21'  
Nail & KC Remon. tag E. side dbl. 10" Ash N 30° W 2.66'  
Nail & KC Remon. tag N. side 10" Nut Tree N 40° E 6.73' (m. 6.81')  
Nail & KC Remon. tag N. side 8" Elm S 70° E 16.82' (m. 16.85')

The selected location is accepted by me and is generally accepted by professional surveyors as the best available evidence of the position of the original corner.

C. Description of monument for corner and accessories established to perpetuate locating the position of the corner:

J-9 Standard Kent County Witness Monument

Nail & K.C. remon. tag on N side 24" Oak N 60° W 11.55'  
Nail & K.C. remon. tag on S side 12" Poplar S 90° E 16.21'  
Nail & K.C. remon. tag on E side dbl. 10" Ash N 30° W 2.66'  
Nail & K.C. remon. tag on N side 10" Nut Tree N 40° E 6.81'  
Nail & K.C. remon. tag on N side 8" Elm S 70° E 16.85'

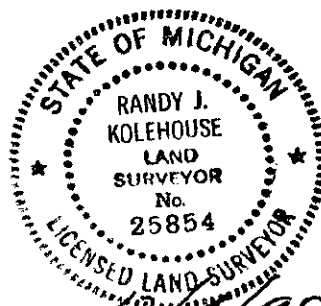

Signed by Randy J. Kolehouse

Date 2/19/98

EARTH TECH

Surveyor's Michigan License No. 25854