

MAR 08 1999

SECTION

LAND CORNER RECORDATION CERTIFICATE
Filing Requirement of Act 74, Mich. P.A. 1970
KENT COUNTY REMONUMENTATION

REG. OF DEEDS

38 DEC 23 AM 8:55

STATE OF MICHIGAN
COUNTY OF KENT
RECEIVED FOR RECORD

other code # 12
11069

Register of Deeds Stamp & File Number

For corners in

Kent
(County)

Located in: Vergennes
Township

Corner Code #

1. Public Land Survey

T 7N R 9W L-9E

T R

T R Witness Monument

T R

2. Property Controlling
in Section

S T R

S T R

3. Miscellaneous
Property in Sec.

S T R

S T R

4. Lot No. , Recorded Plat

5. Private Claims

I, Randy Kolehouse, in a field survey on January 15 19 98, do hereby certify that under requirements of P.A. 74 Michigan P.A. of 1970, the corner points mentioned in lines 1 and 2 above were in conformance with regulations and rules therefore as required in the current manual of survey instructions of the United States Department of the Interior, Bureau of Land Management or by a decree of a Court of Law and/or that the corner points mentioned in lines 3, 4 and 5 above were in conformance with the rules of the Michigan Board of Land Surveyors or by a Decree of a Court of Law; established, re-established, monumented, re-monumented, recovered, found as expressed below:

NOTE: Not more than 4 corners, all in the same town and range, may be recorded on this certificate.

A. Description of original monument and accessories and/or subsequent restoration:

L-9	1838	G.L.O. Notes	N. Brookfield	Set Post
	1989	L.C.R.C. #5226	John Bueche	Set Iron
	1995	L.C.R.C. #8272	William Byl	Iron and Cap

P.A. 345 1990 KENT COUNTY

PEER APPROVED 12/15/98

CHAIRMAN *Harry Fisher*

This corner was originally approved by the Kent County Remonumentation Peer Group and monumented by John Bueche on 10/10/89 and was recorded per L.C.R.C. #5226.

B. Description of corner evidence found and/or method applied in restoring or reestablishing corner:

L-9 Found a capped iron 3' Southeast of the Southeast bank of the Flat River per L.C.R.C.'s #5226 and #8272 as set by John Bueche 974.66' East of the 1/4 corner on section line between Sections 24 and 25.

L.C.R.C. #5226

L.C.R.C. #8272

Nail & Remon tag in W side 10" Cedar S 40° W 5.32'
Nail & Remon tag in E side 10" Cedar N 30° E 12.05'
Nail & Remon tag in N side 12" Cedar S 70° W 23.35'
Nail & Remon tag in W side 12" Cedar S 25° W 17.35' Slope meas.
Nail & Remon tag in W side 10" Cedar S 70° E 13.90' Slope meas.


Nail & KC Remon. tag W. side 10" Cedar S 40° W 5.22' (m. 5.24')
Nail & KC Remon. tag E. side 10" Cedar N 30° E 12.08'
Nail & KC Remon. tag W. side 12" Cedar S 25° W 17.28' Slope meas.
Nail & KC Remon. tag W. side 10" Cedar S 70° E 13.80' (m. 13.78') Slope meas.
Nail & KC Remon. tag S. side 8" Cedar S 60° W 20.56'

The selected location is accepted by me and is generally accepted by professional surveyors as the best available evidence of the position of the original corner.

C. Description of monument for corner and accessories established to perpetuate locating the position of the corner:

L-9 Capped Iron

Nail & K.C. remon. tag on W side 10" cedar S 40° W 5.24'
Nail & K.C. remon. tag on E side 10" Cedar N 30° E 12.08
Nail & K.C. remon. tag on W side 12" Cedar S 25° W 17.29' Slope meas.
Nail & K.C. remon. tag on W side 10" Cedar S 70° E 13.78' Slope meas.
Nail & K.C. remon. tag on S side 8" Cedar S 60° W 20.56'

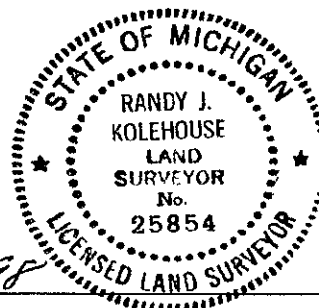

Signed by *Randy J. Kolehouse*

Date 12/14/98

EARTH TECH

Surveyor's Michigan License No. 25854