

SURVEY & REMONUMENTATION

APR 28 1995

LAND CORNER RECORDATION CERTIFICATE Filing Requirement of Act 74, Mich. P.A. 1970 KENT COUNTY REMONUMENTATION

For corners in **COMMISSION**

STATE OF MICHIGAN
COUNTY OF KENT
RECEIVED FOR RECORD

94 DEC 29 AM 11:11

W. J. Ford
REG. OF DEEDS

Prop Control
7933 #2

Register of Deeds Stamp & File Number

Kent (County) Located in: Corner Code #

1. Public Land Survey	T <u>7N</u>	R <u>11W</u>	<u>E-2</u>
	T _____	R _____	_____
	T _____	R _____	_____
	T _____	R _____	_____
2. Property Controlling In Section	S _____	T _____	R <u>Ref. Mon. 650.0' South of E-2 & Ref. Mon.</u>
	S _____	T _____	R _____
3. Miscellaneous Property In Sec.	S _____	T _____	R <u>680.0' East of E-2</u>
	S _____	T _____	R _____


4. Lot No. _____, Recorded Plat _____
5. Private Claims _____

I, Randy Kolehous, In a field survey on September 29 19 94, do hereby certify that under requirements of P.A. 74 Michigan P.A. of 1970, the corner points mentioned in lines 1 and 2 above were in conformance with regulations and rules therefore as required in the current manual of survey instructions of the United States Department of the Interior, Bureau of Land Management or by a decree of a Court of Law and/or that the corner points mentioned in lines 3, 4 and 5 above were in conformance with the rules of the Michigan Board of Land Surveyors or by a Decree of a Court of Law; established, re-established, monumented, re-monumented, recovered, found as expressed below:

NOTE: Not more than 4 corners, all in the same town and range, may be recorded on this certificate.

A. Description of original monument and accessories and/or subsequent restoration:

E-2	1817	G.L.O. Notes	Mullett	No Corner Set/Falls In Lake
	1952	Survey Notes	Williams & Works	Set by Comps. at Gov. Dist. North of SW Corner Section 4

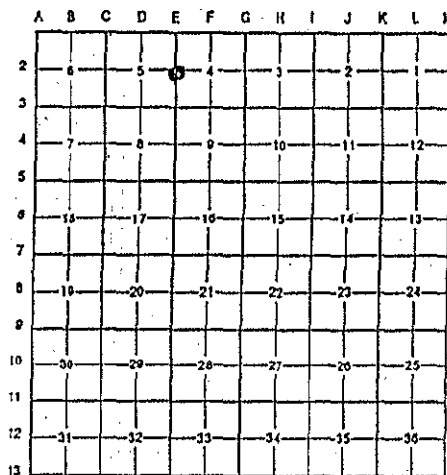

P.A. 345 1990 KENT COUNTY

PEER APPROVED 11/3/94

CHAIRMAN *Harry J. Fabene*

B. Description of corner evidence found and/or method applied in restoring or reestablishing corner:

E-2 This corner falls in Lamberton Lake. A computed point was established by Williams & Works by proportional meas. North of SW corner of Section 4 (2643.0'). They then established the Center of Section 4 at the intersection of 1/4 lines. We found a Kent County monument at East 1/4 corner and Iron at Center Section as set in 1952 by Williams & Works. This line was then extended West to intersection West line Section 4 (line between SW and NW corner of Section 4) for the 1/4 corner between Section 4 & 5. This point is 2640.3' North of the SW corner of Section 4.

The selected location is accepted by me and is generally accepted by professional surveyors as the best available evidence of the position of the original corner.

C. Description of monument for corner and accessories established to perpetuate locating the position of the corner:

E-2 Set reference monuments 650.0' South and 680.0 feet East of E-2.

Reference Monument on Section line 650.0' South of E-2

Reference Monument on E-W 1/4 line 680.0' East of E-2

Nail & K.C. remon. tag in S side 15" Willow East 72.19'
Nail & K.C. remon. tag in SW side 8" Oak S 25° E 165.96'
Nail & K.C. remon. tag in NE side 8" Oak N 50° W 198.83'
E'y cor. brick bldg. N 75° W 129.55'
C/L M.H. cover S 40° W 42.36'
K.C. Mon. at E-3 South 1990.3'

Nail & K.C. remon. tag in W side 16" Willow N 20° E 122.58'
Nail & K.C. remon. tag in NW side 18" Oak N 55° E 201.88'
Nail & K.C. remon. tag in NE side 16" Willow S 10° E 82.95'
NW cor. beach hse. N 10° E 140.2'
NW cor. conc. pad S 15° W 58.48'
K.C. Mon. at F-2 East 1960.3'

Signed by *Randy J. Kolehous*

Date 12/20/94

Surveyor's Michigan License No. 25854

