

SURVEY & REMONUMENTATION

MAY 09 1996

other
KENT COUNTY REMONUMENTATION
LAND CORNER RECORDATION CERTIFICATE
Filing Requirement of Act 74, Mich. P.A. 1970

COMMISSION

For corners in

Kent

(County)

Located In:

Spencer Township

Corner Code #

1. Public Land Survey

T R

T R

T R

T R

2. Property Controlling
in Section

S 13 T 10N R 9W

S T R

3. Miscellaneous

S T R

Property in Sec.

S T R

Other Code
#14
Wit. Mon.

STATE OF MICHIGAN
COUNTY OF KENT
RECEIVED FOR RECORD

93 OCT -4, PM 1:53

REG. OF DEEDS

6847

Register of Deeds Stamp & File Number

4. Lot No. , Recorded Plat

5. Private Claims

I, Rodney D. Unema in a field survey on September 7, 19 93,
do hereby certify that under requirements of P.A. 74, Michigan P.A. of 1970, the corner points mentioned
in lines 1 and 2 above were in conformance with regulations and rules therefore as required in the
current manual of survey instructions of the United States Department of the Interior, Bureau of Land
Management or by a decree of a Court of Law and/or that the corner points mentioned in lines 3, 4 and 5
above were in conformance with the rules of the Michigan Board of Land Surveyors or by a Decree of a
Court of Law; established, re-established, monumented, re-monumented, recovered, found as
expressed below:

NOTE: Not more than 4 corners, all in the same town and range, may be recorded
on this certificate.

A. Description of original monument and accessories and/or subsequent restoration:

None

B. Description of corner evidence found and/or method applied in restoring or reestablishing corner:

Found capped iron +27' South of South edge of Bass Lake on line with existing S 1/4 cor.
Mon. and re-rod at Center of Section 13.
Iron is 1023.47' North of re-rod at Center Section.

C. Description of monument for corner and accessories established to perpetuate locating the position of the corner:

Replaced existing iron with Std. K.C. Harrison Mon. (4"x30") flush with ground.

Set nail & KC tag in E sde 24" Oak N19°W 17.27'

Set nail & KC tag in S sde 30" Oak N55°E 35.55'

Set nail & KC tag in W sde 32" Oak S08°E 27.56'

Set nail & KC tag in N'y base of 26" Oak S58°W 74.92'

Waters edge of Bass Lake North 29.5'

Center of Section 13 S00°04'33"E 1023.47'

	A	B	C	D	E	F	G	H	I	J	K	L	M
2	6	5	4	3	2	1							
3													
4	7	8	9	10	11	12							
5													
6	18	17	16	15	14	13							
7													
8	19	20	21	22	23	24							
9													
10	30	29	28	27	26	25							
11													
12	31	32	33	34	35	36							
13													

Signed by


Rodney D. Unema

Date September 10, 1993

Surveyor's Michigan License No.

33987

Note: See Survey L 257 P 36 for survey map

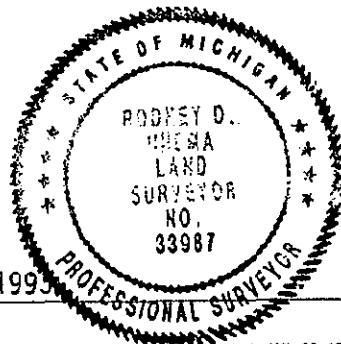

FORM APPROVED BY MICHIGAN STATE BOARD OF LAND SURVEYORS, JAN. 28, 1971
REVISED MAY 14, 1975
REVISED JAN., 1983

Accepted for record by
 Kent County Register of
 Deeds
 19 93 Oct 4, 2:00 P.M. In
 Liber 357 page 35


SURVEY OF: SECTION 12, T10N, R9W SPENCER TOWNSHIP, KENT COUNTY, MICHIGAN

LEGEND:

- ⊙ = EXISTING HARRISON MONUMENT
- = SET HARRISON MONUMENT AT EXISTING CENTER OF SECTION
- △ = SET HARRISON MONUMENT AS WITNESS MONUMENT

BEARINGS ARE BASED ON SOLAR OBSERVATION

1" = 1000'

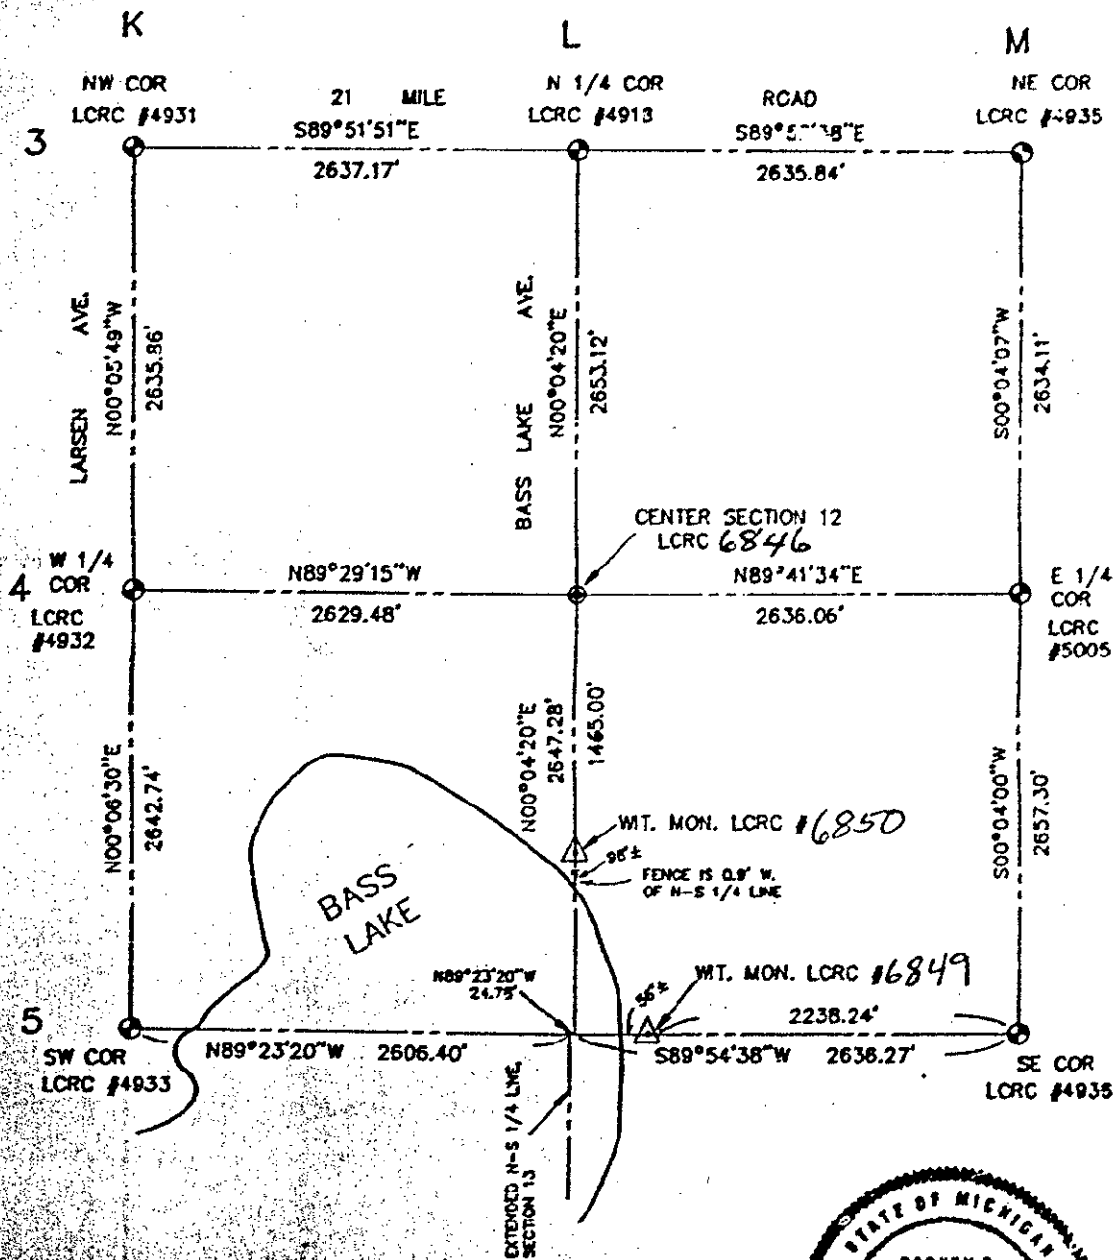

SURVEYOR'S CERTIFICATE

I hereby certify that this survey has been prepared in conformance with the requirements of Act 201, P. A. 1979, and of Act 206, P. A. 1972, and that the survey error of closure is 1:10,000 and that this instrument is therefore in proper form for recording at the County Office of Register of Deeds.

Rodney D. Unema

R.L.S. No. 33



- D = Deeded dimension
- M = Measured dimension
- P = Platted dimension
- ⊙ = Set iron stake
- = Found iron stake
- ⊙ = Concrete monument
- △ = Fenced line



excel engineering inc.

5262 CLYDE PARK, S.W. • GRAND RAPIDS, MI 49508-9724

PHONE (616) 531-3600

File No. 93189A Date: September 28, 1993