

SURVEY & REMONUMENTATION

MAY 09 1996

other

LAND CORNER RECORDATION CERTIFICATE COMMISSION Filing Requirement of Act 74, Mich. P.A. 1970

For corners in

Kent
County

Located In:

Corner Code: 11

1. Public Land Survey T 10N R 11W
T R
T R
T R
2. Property Controlling S T R
in Section S T R
3. Miscellaneous S T R
Property in Sec. S T R

West witness
monument to J-3

other Code
#4

93 AUG 21 1996

6806

Register of Deeds Stamp & File Number

4. Lot No. Recorded Plat
5. Private Claims

I, Wallace E. Glaza, in a field survey on August 12, 1993

do hereby certify that under requirements of P.A. 74, Michigan P.A. of 1970, the corner points mentioned in lines 1 and 2 above were in conformance with regulations and rules therefore as required in the current manual of survey instructions of the United States Department of the Interior, Bureau of Land Management or by a decree of a Court of Law and/or that the corner points mentioned in lines 3, 4 and 5 above were in conformance with the rules of the Michigan Board of Land Surveyors or by a Decree of a Court of Law, established, re-established, monumented, re-monumented, recovered, found as expressed below:

NOTE: Not more than 4 corners, all in the same town and range, may be recorded on this certificate.

A. Description of original monument and accessories and/or subsequent restoration:

No previous history.

B. Description of corner evidence found and/or method applied in restoring or reestablishing corner:


West witness monument to J-3, T10N, R11W, Solon Township, Kent County, Michigan.

Set standard 4" x 30" Harrison Monument on a straight line between I-3 and the computed location of J-3, 1866.94' East of I-3.

C. Description of monument for corner and accessories established to perpetuate locating the position of the corner:

West witness monument to J-3 (standard 4" x 30" Harrison Monument)

- 1) Nail and tag in SE side 8" tree N10°E 44.69'
- 2) Nail and tag in SE side 8" Birch N29°E 25.84'
- 3) Nail and tag in N side 14" tree S15°W 8.03'
- 4) Nail and tag in SW side 16" tree S57°E 21.48'
- 5) Nail and tag in N side 18" Maple S87°W 21.99'
- 6) East-West wire fence South 1.0'

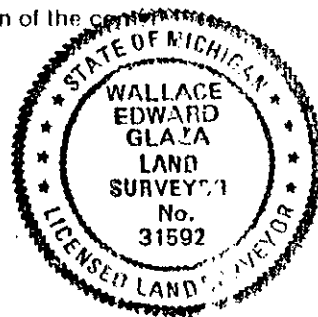

Signed by Wallace E. Glaza Date 8-17-93
Surveyor's Michigan License No. 31592