

MAY 22 2000

KENT COUNTY REMONUMENTATION

SECTION

LAND CORNER RECORDATION CERTIFICATE
Filing Requirement of Act 74, Mich. P.A. 1970

For corners in

KENT COUNTY

(County)

Located In:

Corner Code #

1. Public Land Survey

T^{10N} R^{12W}

Tyrone Twp.

T^{10N} R^{12W}

D-1

T^{10N} R^{12W}

T^{10N} R^{12W}

T^{10N} R^{12W}

2. Property Controlling
in Section

S

T^{10N} R^{12W}

S

T^{10N} R^{12W}

3. Miscellaneous
Property in Sec.

S

T^{10N} R^{12W}

S

T^{10N} R^{12W}

4. Lot No. _____, Recorded Plat _____

5. Private Claims _____

I, Kirk Breitels, in a field survey on Sept. 22, 19 99 do hereby state that under requirements of P.A. 74, Michigan P.A. of 1970, the corner points mentioned in lines 1 and 2 above were in conformance with regulations and rules therefore as required in the current manual of survey instructions of the United States Department of the Interior, Bureau of Land Management or by a decree of a Court of Law and /or that the corner points mentioned in lines 3, 4 and 5 above were in conformance with the rules of the Michigan Board of Land Surveyors or by a Decree of a Court of Law; established, re-established, monumented, recovered, found as expressed below:

NOTE: Not more than 2 corners, all in the same town and range, may be recorded on this certificate.

A. Description of original monument and accessories and/or subsequent restoration:

D-1	1837	GLO	Whitcomb	Not Set
	1973	LCRC #537	Spicer	Set "T" Iron
	1985	LCRC #4371	Ochs	Set Kent County Monument on Twp. Line
	1994	LCRC #7522	J. Glaza	Kent County Monument

The position of this corner was previously approved by the Kent County Remonumentation Peer Group, monumented by Norman L. Ochs on 10-17-85 and was recorded per LCRC #4371.

B. Description of corner evidence found and/or method applied in restoring or reestablishing corner:

D-1 Found Kent County Monument (Harrison) per witnesses from above LCRC as set on Twp. Line by Norman L. Ochs in place of the "T" Iron he found. Said "T" Iron checks with LCRC #537.

LCRC #4371

LCRC #7522

Nail & Remon. tag 15" Tw. Basswood N71°E 56.70'

Nail & Remon. tag 12" Red Oak N10°E 46.32'

Nail & Remon. tag T. Pole S73°W 81.48'

SW corner house N50°E 137.46'

Nail & Remon. tag 28" R. Oak N51°W 22.34'

Nail & Remon. tag P. Pole S70°W 81.37'

Nail & Remon. tag 12" R. Oak N10°E 46.32'

Nail & Remon. tag 24" Oak N58°W 96.03'

The selected location is accepted by me and is generally accepted by professional surveyors as the best available evidence of the position of the corner.

C. Description of monument for corner and accessories established to perpetuate locating the position of the corner:

D-1 Standard Kent County Monument

Nail & KC Remon. tag W. side 14" Red Oak

N10°E 46.35'

SW corner house foundation

N50°E 137.60'

Nail & KC Remon. tag SE side P. Pole


S70°W 81.45'

Nail & KC Remon. tag S. side 27" Oak

N58°W 96.30'

SE cor. Sec. 32-11-12 (Newaygo Co. Mon.)

East 305.63'

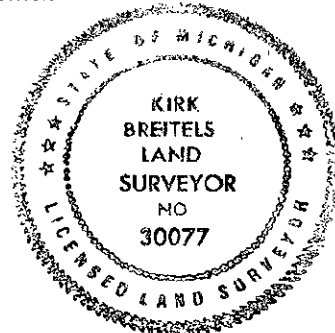

Signed by Kirk Breitels

Date 10/20/99

Surveyor's Michigan License No. 30077