

SURVEY &
REMONUMENTATION

APR 28 1995

COMMISSION

LAND CORNER RECORDATION CERTIFICATE

Filing Requirement of Act 74, Mich. P.A. 1970

For corners in

Keweenaw

(County)

Located In:

Corner Code ##

1. Public Land Survey

T 57N R 32W

A-5

T _____ R _____

T _____ R _____

T _____ R _____

2. Property Controlling
in Section

S _____ T _____ R _____

S _____ T _____ R _____

3. Miscellaneous

S _____ T _____ R _____

Property in Sec.

S _____ T _____ R _____

4. Lot No. _____, Recorded Plat _____

5. Private Claims _____

REGISTER'S OFFICE

County of Keweenaw } SS

Received for Record, the 15th

day of December A.D. 1994

at 3:00 o'clock P.M., and Recorded

in Liber _____ of LCR

on page 123

Marjorie W. Winkler
Register of Deeds

Register of Deeds Stamp & File Number

I, John I. Haatja, in a field survey on November 21, 19 94,
do hereby certify that under requirements of P.A. 74, Michigan P.A. of 1970, the corner points mentioned
in lines 1 and 2 above were in conformance with regulations and rules therefore as required in the
current manual of survey instructions of the United States Department of the Interior, Bureau of Land
Management or by a decree of a Court of Law and/or that the corner points mentioned in lines 3, 4 and 5
above were in conformance with the rules of the Michigan Board of Land Surveyors or by a Decree of a
Court of Law; established, re-established, monumented, re-monumented, recovered, found as
expressed below:

**NOTE: Not more than 4 corners, all in the same town and range, may be recorded
on this certificate.**

A. Description of original monument and accessories and/or subsequent restoration:

A-5 Sec. Cor. 7 & 18, T57N-R32W and 12 & 13, T57N-R33W.

Orig. Notes: Wood Post for corner.

Maple 10" S $9\frac{1}{2}^{\circ}$ W 15 lks.

Fir 8" N 14° W 36 lks.

1 $\frac{1}{2}$ " iron pipe was noted at corner during survey for
Weglarz in 1985. No record of who set pipe.

B. Description of corner evidence found and/or method applied in restoring or reestablishing corner:

A-5 Sec. Cor. 7 & 18, T57N-R32W and 12 & 13, T57N-R33W.

Found 1 $\frac{1}{2}$ " bent pipe at fence intersection.

Restored corner at pipe location.

C. Description of monument for corner and accessories established to perpetuate locating the position of the corner:

A-5 Sec. Cor. 7 & 18, T57N-R32W and 12 & 13, T57N-R33W.

Set 1" pipe with brass cap as a careful and faithful perpetuation
of the position of the original corner.

10" R. Maple N 77° E 8.57'

3" H. Maple S 46° W 5.20'

6" R. Maple N 62° W 10.94'

3" H. Maple N 5° E 36.66'


	A	B	C	D	E	F	G	H	I	J	K	L	M
2	6		5		4		3		2		1		
3													
4	7		8		9		10		11		12		
5													
6	18		17		16		15		14		13		
7													
8	19		20		21		22		23		24		
9													
10	30		29		28		27		26		25		
11													
12	31		32		33		34		35		36		
13													

Ratified by Peer Group

In accordance with P.A. 345

Co. Rep. James M. Haatja

Date 11/16/94

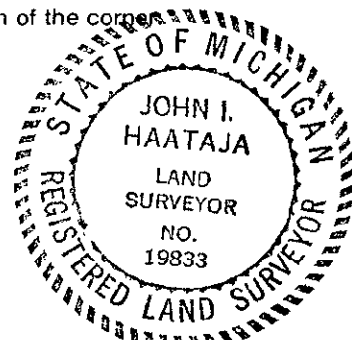

Signed by John I. Haatja
Surveyor's Michigan License No. 19833

Date November 23, 1994