

APR 28 1995

COMMISSION

LAND CORNER RECORDATION CERTIFICATE Filing Requirement of Act 74, Mich. P.A. 1970

For corners in

Keweenaw

(County)

Located In:

Corner Code #

1. Public Land Survey

T 57N R 32W

E-1

2. Property Controlling
In Section

S T R

3. Miscellaneous
Property in Sec.

S T R

4. Lot No. , Recorded Plat

5. Private Claims

REGISTER'S OFFICE

County of Keweenaw } SS

Received for Record, the 15th
day of December A.D. 1994
at 3:00 o'clock P. M., and Recorded
in Liber. 115 of LCR
on page 115

Register of Deeds

Register of Deeds Stamp & File Number

I, John I. Haataja, in a field survey on November 15, 1994

do hereby certify that under requirements of P.A. 74, Michigan P.A. of 1970, the corner points mentioned in lines 1 and 2 above were in conformance with regulations and rules therefore as required in the current manual of survey instructions of the United States Department of the Interior, Bureau of Land Management or by a decree of a Court of Law and/or that the corner points mentioned in lines 3, 4 and 5 above were in conformance with the rules of the Michigan Board of Land Surveyors or by a Decree of a Court of Law; established, re-established, monumented, re-monumented, recovered, found as expressed below:

NOTE: Not more than 4 corners, all in the same town and range, may be recorded on this certificate.

A. Description of original monument and accessories and/or subsequent restoration:

E-1 Northeast Corner of Section 5.

Original Notes: Wood Post set for corner.

12" Cedar N 39° E 28 lks.

8" Fir N 60° W 19 lks.

Iron pipe noted by Kline & Gillies on May 16, 1946.

B. Description of corner evidence found and/or method applied in restoring or reestablishing corner:

E-1 Northeast Corner of section 5.

Found 1" iron pipe per Liber 1, Page 33, Keweenaw County records.

Restored corner at location of 1" iron pipe.

C. Description of monument for corner and accessories established to perpetuate locating the position of the corner:

E-1 Northeast corner of Section 5.

Accepted 1" iron pipe as careful and faithful perpetuation of the position of the original corner.

Set brass cap.


10" W. Birch N 32° W 12.30'

10" Balsam N 55° E 5.69'

10" W. Birch S 06° W 18.36'

6" Balsam N 71° W 8.06'

Ratified by Peer Group
In accordance with P.A. 345
Co. Rep. *[Signature]*
Date 11/16/94

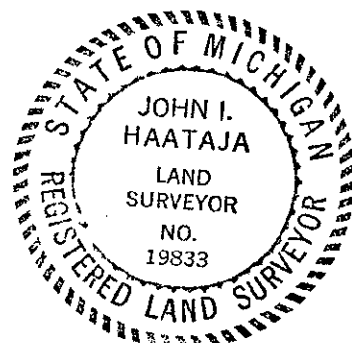

Signed by *[Signature]*

Date

November 22, 1994

Surveyor's Michigan License No. 19833