

SURVEY &
REMONUMENTATION

APR 28 1995

COMMISSION

LAND CORNER RECORDATION CERTIFICATE

Filing Requirement of Act 74, Mich. P.A. 1970

For corners in

Keweenaw

(County)

Located In:

Corner Code #

1. Public Land Survey

T 57N R 32W

E-2

T R

T R

T R

2. Property Controlling
in Section

S T R

S T R

3. Miscellaneous

S T R

Property in Sec.

S T R

4. Lot No. , Recorded Plat

5. Private Claims

REGISTER'S OFFICE

County of Keweenaw

SS 15th

Received for Record, the

day of December A.D. 1994

at 3:00 o'clock P.M., and Recorded

in Liber 1 of LCR

on page 113

Register of Deeds

Register of Deeds Stamp & File Number

I, John I. Haataja, in a field survey on November 8, 19 94, do hereby certify that under requirements of P.A. 74, Michigan P.A. of 1970, the corner points mentioned in lines 1 and 2 above were in conformance with regulations and rules therefore as required in the current manual of survey instructions of the United States Department of the Interior, Bureau of Land Management or by a decree of a Court of Law and/or that the corner points mentioned in lines 3, 4 and 5 above were in conformance with the rules of the Michigan Board of Land Surveyors or by a Decree of a Court of Law; established, re-established, monumented, re-monumented, recovered, found as expressed below:

NOTE: Not more than 4 corners, all in the same town and range, may be recorded on this certificate.

A. Description of original monument and accessories and/or subsequent restoration:

E-2 1/4 Corner between Section 4 & 5.

Orig. Notes: Set Wood Post.

10" Fir S 70° W 31 lks.

6" Fir S 70° E 9 lks.

B. Description of corner evidence found and/or method applied in restoring or reestablishing corner:

E-2 1/4 Corner between Section 4 & 5.

No evidence of original corner found.

Re-established corner by single proportionate measure.

C. Description of monument for corner and accessories established to perpetuate locating the position of the corner:

E-2 1/4 Corner between Section 4 & 5.

Set 1" iron pipe with brass cap and is a careful and faithful re-establishment of the position of the original corner.

4" Cedar S 60° E 8.26'

4" Spruce S 40° W 18.78'


4" Spruce N 64° W 14.15'

6" Cedar N 47° E 15.75'

Ratified by Peer Group
In accordance with P.A. 345

Co. Rep. James M. Hahlik

Date 11/16/94

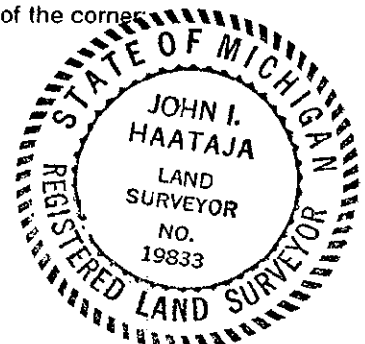

Signed by John I. Haataja
Surveyor's Michigan License No. 19833

Date November 22, 1994