

SURVEY &  
REMONUMENTATION

OCT 08 1997

COMMISSION

LAND CORNER RECORDATION CERTIFICATE  
Filing Requirement of Act 74, Mich. P.A. 1970

For corners in  
KEWEENAW  
(County)

Located In:

Corner Code #

1. Public Land Survey T 57N R 32W G-12  
T      R       
T      R       
T      R       
2. Property Controlling S      T      R       
in Section S      T      R       
3. Miscellaneous S      T      R       
Property in Section S      T      R

4. Lot No.         , Recorded Plat         

5. Private Claims         

REGISTER'S OFFICE

County of Keweenaw } SS 29<sup>th</sup>

Received for Record, the 29<sup>th</sup>  
day of July A.D. 1997  
at 10:00 o'clock A. M., and Recorded  
in Liber 1 of LCR  
on page 164

Marjorie W. W. W.  
Register of Deeds

Register of Deeds Stamp & File Number

I, R. W. CRAMPTON, in a field survey on JUNE 14, 1985  
do hereby certify that under requirements of P.A. 74, Michigan P.A. of 1970, the corner points mentioned  
in lines 1 and 2 above were in conformance with regulations and rules therefore as required in the current  
manual of survey instructions of the United States Department of the Interior, Bureau of Land  
Management or by a decree of a Court of Law and/or that the corner points mentioned in lines 3, 4 and  
5 above were in conformance with the rules of the Michigan Board of Professional Surveyors or by a  
Decree of a Court of Law; established, re-established, monumented, re-monumented, recovered, found  
as expressed below:

NOTE: Not more than 4 corners, all in the same town and range, may be recorded  
on this certificate.

A. Description of original monument and accessories and/or subsequent restoration:


G-12 WEST 1/4 CORNER-SET POST-YELLOW BIRCH 8 N80W 13, SUGAR 12 S70E 7.

B. Description of corner evidence found and/or method applied in restoring or reestablishing corner:

G-12 WEST 1/4 CORNER-1/2" RE-ROD WITH L.L.S. #16936 CAP FOUND.

C. Description of monument for corner and accessories established to perpetuate locating the position of the corner:

G-12 (RESET) 1" IRON PIPE WITH 4" BRASS CAP WAS WITNESSED WITH SURVEY TAG NAILED TO:  
8" WHITE BIRCH TREE N49 E 28.68', 10" OAK TREE S74 E 16.74',  
UTILITY POLE S56 W 34.87", 6" WHITE BIRCH TREE N44 W 47.82'.

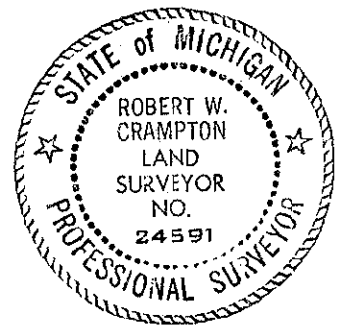

Ratified by Peer Group  
in accordance with P.A. 345  
Co. Rep. James M. Harkins  
Date 7/20/97

Signed by Robert W. Crampton  
Surveyor's Michigan License No. 24591

Date JULY 22, 1997