

SURVEY & REMONUMENTATION

MAR 19 1997

COMMISSION

LAND CORNER RECORDATION CERTIFICATE
Filing Requirement of Act 74, Mich. P.A. 1970

For corners in

Keweenaw
(County)

Located In:

Corner Code #

1. Public Land Survey

T 58 R 29
T 58 R 29
T R
T R

G/H 3 (11)
I - 4/5 (5)

2. Property Controlling
in Section

S T R
S T R

3. Miscellaneous
Property in Sec.

S T R
S T R

REGISTER'S OFFICE

County of Keweenaw } SS

Received for Record, the 9th

day of December A.D. 1996

at 1:00 o'clock P.M., and Recorded

in Liber 1 of LCR

on page 152

Robert A. Rosenberg, Deputy
Register of Deeds

Register of Deeds Stamp & File Number

4. Lot No. , Recorded Plat

5. Private Claims

I, John I. Haataja, in a field survey on November 14, 1996, do hereby certify that under requirements of P.A. 74, Michigan P.A. of 1970, the corner points mentioned in lines 1 and 2 above were in conformance with regulations and rules therefore as required in the current manual of survey instructions of the United States Department of the Interior, Bureau of Land Management or by a decree of a Court of Law and/or that the corner points mentioned in lines 3, 4 and 5 above were in conformance with the rules of the Michigan Board of Land Surveyors or by a Decree of a Court of Law; established, re-established, monumented, re-monumented, recovered, found as expressed below:

NOTE: Not more than 4 corners, all in the same town and range, may be recorded on this certificate.

A. Description of original monument and accessories and/or subsequent restoration:


G/H - 3 Meander corner between 3 & 10.
Wood Post at high water mark.
White Pine 12" S 50 E 37 lks.
Cedar 10" N 41 E 27 lks.

I - 4/5 Meander corner between 10 & 11.
Wood Post
Spruce 9" S 46 E 16 lks.

B. Description of corner evidence found and/or method applied in restoring or reestablishing corner:

G/H - 3 No evidence of original corner
FND. Re-established on line
between S.E. cor. Sec. 3 and
S.W. cor. Sec. 4

I - 4/5 No evidence of original corner
FND. Re-established during
survey of Assessor's Plat of
Lake Medora. This is on line
between N.E. cor. & S.E. cor.
of Sec. 9 & on intermediate
traverse line of the Plat.

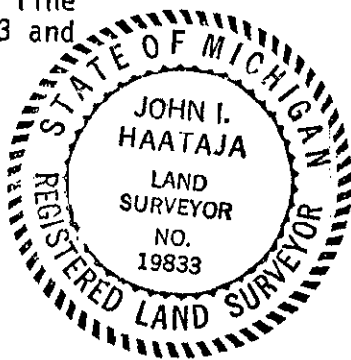

Ratified by Peer Group
In accordance with P.A. 345
Co. Rep. [Signature]
Date 12/6/96

Description of monument for corner and accessories established to perpetuate locating the position of the corner:

G/H - 3 Meander corner between Sec. 3 & 10.
Set 1" pipe with brass cap
6" Cedar N 58 W 9.69'
16" Cedar N 28 E 7.66'
4" B. Fir S 51 W 10.93'
8" Cedar S 69 E 13.85'
15' West to waters edge

I - 4/5 Meander cor. between 10 & 11.
Set 1" pipe with brass cap flush
Lot Pin N 73 W 40.51'
Conc. Mon. S 73 E 56.73'
Deck Post/Tag S 16 E 8.60'
4" B. Fir S 73 W 43.57'
3' N. to waters edge

Surveyed by [Signature]
Surveyor's Michigan License No. 19833

Date 11/27/96