

SURVEY & REMONUMENTATION

MAR 19 1997

LAND CORNER RECORDATION CERTIFICATE

COMMISSION Filing Requirement of Act 74, Mich. P.A. 1970

For corners in

Keweenaw

(County)

Located in:

Corner Code ##

1. Public Land Survey

T 58 R 29

G - 2/3 (2)

T 58 R 29

G - 4/5 (4)

T R

T R

2. Property Controlling in Section

S T R

S T R

3. Miscellaneous

S T R

Property in Sec.

S T R

4. Lot No. , Recorded Plat

5. Private Claims

REGISTER'S OFFICE } SS

County of Keweenaw

Received for Record, the 9th

day of December A.D. 1996

at 1:00 o'clock P.M., and Recorded

in Liber 1 of LCR

on page 153

Roberta Rosenberger, D.D.

Register of Deeds

Register of Deeds Stamp & File Number

I, John I. Haataja, in a field survey on September 19, 1996

do hereby certify that under requirements of P.A. 74, Michigan P.A. of 1970, the corner points mentioned in lines 1 and 2 above were in conformance with regulations and rules therefore as required in the current manual of survey instructions of the United States Department of the Interior, Bureau of Land Management or by a decree of a Court of Law and/or that the corner points mentioned in lines 3, 4 and 5 above were in conformance with the rules of the Michigan Board of Land Surveyors or by a Decree of a Court of Law; established, re-established, monumented, re-monumented, recovered, found as expressed below:

NOTE: Not more than 4 corners, all in the same town and range, may be recorded on this certificate.

A. Description of original monument and accessories and/or subsequent restoration:


G - 2/3 Meander cor. between 3 & 4.
Wood Post
Cedar 10" N 30 E 17 lks.
Birch 8" N 20 W 9 lks.

G - 4/5 Meander corner between 9 & 10.
Wood Post
White Pine 10" S 15 E 23 lks.
White Pine 16" S 28 W 17 lks.

B. Description of corner evidence found and/or method applied in restoring or reestablishing corner:

G - 2/3 No evidence of original cor. FND.
Re-established corner by extending line from NW cor. of Sec. 3 South through the 1/4 cor. to high water mark.

G - 4/5 No evidence of original cor. FND.
Re-established during survey of Assessor's Plat of Lake Medora.

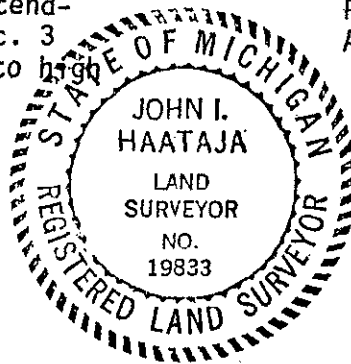

Ratified by Peer Group
In accordance with P.A. 345
Co. Rep. James M. Huhli
Date 12/6/96

Description of monument for corner and accessories established to perpetuate locating the position of the corner:

G - 2/3 Meander corner between 3 & 4.
1" pipe with brass cap
18" W. Pine N 6 W 18.56'
5" Maple N 56 E 16.17'
7" Cedar N 83 E 30.22'
4" Cedar S 54 E 38.79'
2' South to waters edge

G - 4/5 Meander cor. between 9 & 10.
Grouted brass cap in rock face.
N.E. corner lowest conc. dock step N 80 W 31.13'
6" Cedar S 83 E 30.61'
6" Cedar S 20 E 4.41'
28" W. Pine S 33 W 24.63'
5' N. to waters edge

ed by John I. Haataja

Date 11/27/96

Surveyor's Michigan License No. 19833