

SURVEY &
REMONUMENTATION

JAN 21 1998

SECTION

LAND CORNER RECORDATION CERTIFICATE
Filing Requirement of Act 74, Mich. P.A. 1970

For corners in

Keweenaw
(County)

Located In:

Corner Code #

1. Public Land Survey

T 58N R 29W G-12
T 58N R 29W MC 12
T R
T R
T R
T R

2. Property Controlling
in Section

S T R
S T R

3. Miscellaneous
Property in Sec.

S T R
S T R

4. Lot No. , Recorded Plat

5. Private Claims

REGISTER'S OFFICE

County of Keweenaw } SS

Received for Record, the 30th

day of December A.D. 19 97

at 10:00 o'clock A.M. and Recorded

in Liber 1 of LCR

on page 177

Julie Carlson, Deputy
Register of Deeds

Register of Deeds Stamp & File Number

I, John Haataja, in a field survey on 11/7, 19 97,
do hereby certify that under requirements of P.A. 74, Michigan P.A. of 1970, the corner points mentioned
in lines 1 and 2 above were in conformance with regulations and rules therefore as required in the
current manual of survey instructions of the United States Department of the Interior, Bureau of Land
Management or by a decree of a Court of Law and/or that the corner points mentioned in lines 3, 4 and 5
above were in conformance with the rules of the Michigan Board of Land Surveyors or by a Decree of a
Court of Law; established, re-established, monumented, re-monumented, recovered, found as
expressed below:

NOTE: Not more than 4 corners, all in the same town and range, may be recorded
on this certificate.

A. Description of original monument and accessories and/or subsequent restoration:

G-12 Wood post set in 1847.
Spruce 8" N10°E 21 LKS

MC 12 Wood post set in 1847
W. Pine 16" N27°W 48 LKS
Cedar 10" S40°E 80 LKS

	A	B	C	D	E	F	G	H	I	J	K	L	M
2	6		5		4		3		2		1		
3													
4	7		8		9		10		11		12		
5													
6	13		17		16		15		14		13		
7													
8	19		20		21		22		23		24		
9													
10	30		29		28		27		26		25		
11													
12	31		32		33		34		35		36		
13													

B. Description of corner evidence found and/or method applied in restoring or reestablishing corner:

G-12 No evidence of original corner found
Set 1/4 corner midway between the NW corner
and the SW corner of Section 34.


MC 12 No evidence of original corner found.
Reestablished meander corner on Section line
between NW corner and the SW corner of Section
34 at high watermark.

Ratified by Peer Group
In accordance with P.A. 345
Co. Rep. John Haataja
Date 10/15/97

C. Description of monument for corner and accessories established to perpetuate locating the position of the corner:

G-12 Set 1" pipe with brass cap
6" Red Maple S73°W 21.64'
13" Red Maple N27°W 30.75'
10" Red Maple N77°E 26.92'
10" Red Maple S70°E 33.56'

MC 12 Set 1" pipe with brass cap
5" Cedar N34°W 6.10'
8" Tamarack N36°E 9.76'
6" Tamarack N62°E 47.03'
4" Tamarack S30°W 13.12'

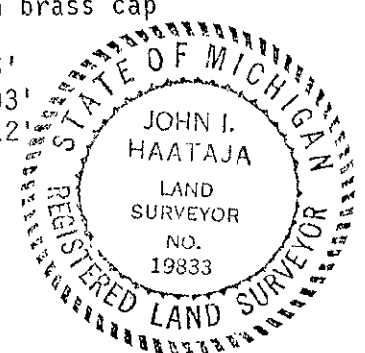

Signed by John I. Haataja
Surveyor's Michigan License No. 19833

Date 12/30/1997