

# SURVEY & REMONUMENTATION

JAN 21 1998

## SECTION

## LAND CORNER RECORDATION CERTIFICATE

Filing Requirement of Act 74, Mich. P.A. 1970

For corners in

Keweenaw

(County)

Located In:

Corner Code ##

1. Public Land Survey

58N 29W

MC 17

58N 29W

MC 13

2. Property Controlling in Section

S T R

3. Miscellaneous Property in Sec.

S T R

4. Lot No. , Recorded Plat

5. Private Claims

REGISTER'S OFFICE

County of Keweenaw SS

Received for Record the 30th

day of December A.D. 19 97

at 10:00 o'clock A.M. and Recorded

in Liber 1 of LCR

on page 180

John I. Haataja, Deputy

Register of Deeds

Register of Deeds Stamp & File Number

I, JOHN I. HAATAJA in a field survey on 11/7, 1997

do hereby certify that under requirements of P.A. 74, Michigan P.A. of 1970, the corner points mentioned in lines 1 and 2 above were in conformance with regulations and rules therefore as required in the current manual of survey instructions of the United States Department of the Interior, Bureau of Land Management or by a decree of a Court of Law and/or that the corner points mentioned in lines 3, 4 and 5 above were in conformance with the rules of the Michigan Board of Land Surveyors or by a Decree of a Court of Law; established, re-established, monumented, re-monumented, recovered, found as expressed below:

NOTE: Not more than 4 corners, all in the same town and range, may be recorded on this certificate.

A. Description of original monument and accessories and/or subsequent restoration:

MC 17 Wood post set in 1847  
Y. Pine 10" S66° W 83 LKS  
Y. Pine 7" N63° W 107 LKS

MC 13 Wood post set in 1847  
Fir 10" N30° E 12 LKS  
Fir 8' N23° W 17 LKS

B. Description of corner evidence found and/or method applied in restoring or reestablishing corner:

MC 17 Reestablished in 1990 and recorded in LCR 1, Page 87, Keweenaw County Records. Reestablished MC and Section line from Monuments as called for in description of U.S. Lighthouse Parcel.


MC 13 No evidence of original corner found. Set MC set S02°-36'-16" E of Section corner at the high watermark which is the equivalent to the Government Course of due South.

Ratified by Peer Group  
In accordance with P.A. 345  
Co. Rep. [Signature]  
Date 10/15/97

C. Description of monument for corner and accessories established to perpetuate locating the position of the corner:

MC 17 Set 1" pipe with brass cap  
12" R. Pine N17° W 35.79'  
16" R. Pine S84° E 2.09'  
16" R. Pine S02° E 49.66  
12" W. Pine N76° W 38.48'

MC 13 Set 1" pipe with brass cap  
15" W. Pine N53° W 121.90'  
12" W. Pine S69° W 220.67'  
Plat Mon. N23° E 132.61'  
Plat Mon. N03° W 150.55'

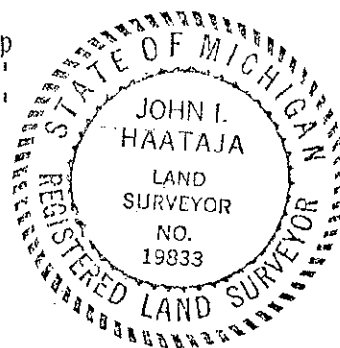

Signed by

Surveyor's Michigan License No. 19833

Date

12/30/1997