

SURVEY &  
REMONUMENTATION

APR 28 1995

COMMISSION

LAND CORNER RECORDATION CERTIFICATE

Filing Requirement of Act 74, Mich. P.A. 1970

For corners in

Keweenaw

(County)

Located In:

Corner Code ##

1. Public Land Survey

T 58N R 32W

B/C-13

T      R     

T      R     

T      R     

2. Property Controlling  
in Section

S      T      R     

S      T      R     

3. Miscellaneous

S      T      R     

Property in Sec.

S      T      R     

4. Lot No.         , Recorded Plat         

5. Private Claims         

REGISTER'S OFFICE

County of Keweenaw

SS

Received for Record, the

20<sup>th</sup>

day of January A.D. 1995

at 10:30 o'clock A. M., and Recorded

in Liber 1 of LCR

on page 130

Manly J. Jorgensen  
Register of Deeds

Register of Deeds Stamp & File Number

I, John I. Haataja, in a field survey on December 1, 19 94

do hereby certify that under requirements of P.A. 74, Michigan P.A. of 1970, the corner points mentioned in lines 1 and 2 above were in conformance with regulations and rules therefore as required in the current manual of survey instructions of the United States Department of the Interior, Bureau of Land Management or by a decree of a Court of Law and/or that the corner points mentioned in lines 3, 4 and 5 above were in conformance with the rules of the Michigan Board of Land Surveyors or by a Decree of a Court of Law; established, re-established, monumented, re-monumented, recovered, found as expressed below:

**NOTE: Not more than 4 corners, all in the same town and range, may be recorded on this certificate.**

A. Description of original monument and accessories and/or subsequent restoration:

B/C-13 Meander Corner between Sec. 31, T58N-R32W and Sec. 6, T57N-R32W.

Orig. Notes: Set Meander Post at HWM

Pine 20" S 28° W 55 lks.

Corner of Shore N 45° E and S 65° W

B. Description of corner evidence found and/or method applied in restoring or reestablishing corner:

B/C-13 Meander Corner between Sec. 31, T58N-R32W and Sec. 6, T57N-R32W.

No trace of original corner found.

Re-established Section line from natural feature calls as noted in original notes.

C. Description of monument for corner and accessories established to perpetuate locating the position of the corner:

B/C-13 Witness Corner Meander Corner between Sec. 31, T58N-R32W and Sec. 6, T57N-R32W.

Set 1" pipe with brass cap as a careful and faithful re-establishment of the position of the original Section line.

5" R. Maple S 56° E 36.26'

4" W. Pine S 15° W 12.35'

5" W. Birch N 61° W 7.44'


14" R. Pine N 53° E 53.86'

Ratified by Peer Group

In accordance with P.A. 345

Co. Rep. James M. Heikkinen

Date 11/16/94

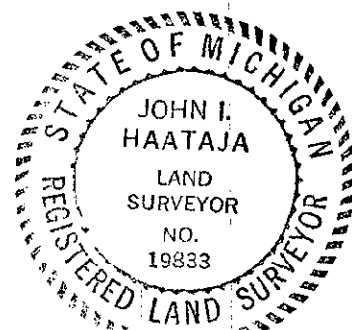

Signed by John I. Haataja

Date December 21, 1994

Surveyor's Michigan License No. 19833